

WATER WELL RECORD Form WWC-5

Division of Water Resources App. No.

Well ID MW-25

Original Record Correction Change in Well Use

1 LOCATION OF WATER WELL: County: Smith	Fraction NE ¼ SW ¼ SE ¼ NE ¼	Section Number 29	Township Number T 3 S	Range Number R 15 <input type="checkbox"/> E <input checked="" type="checkbox"/> W
--	---------------------------------	-----------------------------	---------------------------------	--

2 WELL OWNER: Last Name: Struckhoff First: Cory Business: Address: P.O. Box 434 Address: City: Kensington State: KS ZIP: 66951	Street or Rural Address where well is located (if unknown, distance and direction from nearest town or intersection): If at owner's address, check here: <input type="checkbox"/> 223 S. Main Street, Kensington, KS 66951
---	--

3 LOCATE WELL WITH "X" IN SECTION BOX:
N

S

-----1 mile-----

4 DEPTH OF COMPLETED WELL: **50** ft.
Depth(s) Groundwater Encountered: 1) ft.
2) ft. 3) ft., or 4) Dry Well
WELL'S STATIC WATER LEVEL: **36.32** ft.
 below land surface, measured on (mo-day-yr) **5/11/2021**
 above land surface, measured on (mo-day-yr)
Pump test data: Well water was ft.
after hours pumping gpm
Well water was ft.
after hours pumping gpm
Estimated Yield: gpm
Bore Hole Diameter: **8.75** in. to **50** ft. and
..... in. to ft.

5 Latitude: **39.76471** (decimal degrees)
Longitude: **99.03223** (decimal degrees)
Horizontal Datum: WGS 84 NAD 83 NAD 27
Source for Latitude/Longitude:
 GPS (unit make/model: **EPOCH**)
(WAAS enabled? Yes No)
 Land Survey Topographic Map
 Online Mapper:

6 Elevation: **1776.28** ft. Ground Level TOC
Source: Land Survey GPS Topographic Map
 Other

7 WELL WATER TO BE USED AS:

1. Domestic: <input type="checkbox"/> Household <input type="checkbox"/> Lawn & Garden <input type="checkbox"/> Livestock	5. <input type="checkbox"/> Public Water Supply: well ID 6. <input type="checkbox"/> Dewatering: how many wells? 7. <input type="checkbox"/> Aquifer Recharge: well ID 8. <input checked="" type="checkbox"/> Monitoring: well ID MW-25	10. <input type="checkbox"/> Oil Field Water Supply: lease 11. Test Hole: well ID <input type="checkbox"/> Cased <input type="checkbox"/> Uncased <input type="checkbox"/> Geotechnical 12. Geothermal: how many bores? a) Closed Loop <input type="checkbox"/> Horizontal <input type="checkbox"/> Vertical b) Open Loop <input type="checkbox"/> Surface Discharge <input type="checkbox"/> Inj. of Water 13. <input type="checkbox"/> Other (specify):
2. <input type="checkbox"/> Irrigation	9. Environmental Remediation: well ID	
3. <input type="checkbox"/> Feedlot	<input type="checkbox"/> Air Sparge <input type="checkbox"/> Soil Vapor Extraction	
4. <input type="checkbox"/> Industrial	<input type="checkbox"/> Recovery <input type="checkbox"/> Injection	

Was a chemical/bacteriological sample submitted to KDHE? Yes No If yes, date sample was submitted:

Water well disinfected? Yes No

8 TYPE OF CASING USED: Steel PVC Other CASING JOINTS: Glued Clamped Welded Threaded
Casing diameter **2** in. to **30** ft., Diameter in. to ft., Diameter in. to ft.
Casing height above land surface **3** in. Weight lbs./ft. Wall thickness or gauge No.
TYPE OF SCREEN OR PERFORATION MATERIAL:
 Steel Stainless Steel Fiberglass PVC Other (Specify)
 Brass Galvanized Steel Concrete tile None used (open hole)
SCREEN OR PERFORATION OPENINGS ARE:
 Continuous Slot Mill Slot Gauze Wrapped Torch Cut Drilled Holes Other (Specify)
 Louvered Shutter Key Punched Wire Wrapped Saw Cut None (Open Hole)
SCREEN-PERFORATED INTERVALS: From **30** ft. to **50** ft., From ft. to ft., From ft. to ft.
GRAVEL PACK INTERVALS: From **27.8** ft. to **50** ft., From ft. to ft., From ft. to ft.


9 GROUT MATERIAL: Neat cement Cement grout Bentonite Other
Grout Intervals: From **1** ft. to **27.8** ft., From ft. to ft., From ft. to ft.
Nearest source of possible contamination:
 Septic Tank Lateral Lines Pit Privy Livestock Pens Insecticide Storage
 Sewer Lines Cess Pool Sewage Lagoon Fuel Storage Abandoned Water Well
 Watertight Sewer Lines Seepage Pit Feedyard Fertilizer Storage Oil Well/Gas Well
 Other (Specify)

Direction from well? **E** Distance from well? **20** ft.

10 FROM	TO	LITHOLOGIC LOG	FROM	TO	LITHO. LOG (cont.) or PLUGGING INTERVALS
0	5	Silty Clay	45	50	Clayey Sand
5	10	Silt			
10	18	Silty Clay			
18	27	Sandy Silt			
27	33	Silty Clay			
33	36	Sandy Clay			
36	37	Sand			
37	40	Silty Clay			
40	45	Sand			

Notes:
Kensington Cooperative Assn. KDHE BER Project Code: U6-092-00406

11 CONTRACTOR'S OR LANDOWNER'S CERTIFICATION: This water well was constructed, reconstructed, or plugged under my jurisdiction and was completed on (mo-day-year) **5/12/2020** and this record is true to the best of my knowledge and belief. Kansas Water Well Contractor's License No. **604** This Water Well Record was completed on (mo-day-year) **7/19/2021** under the business name of **Environmental Priority Service** Signature **PTA mT**

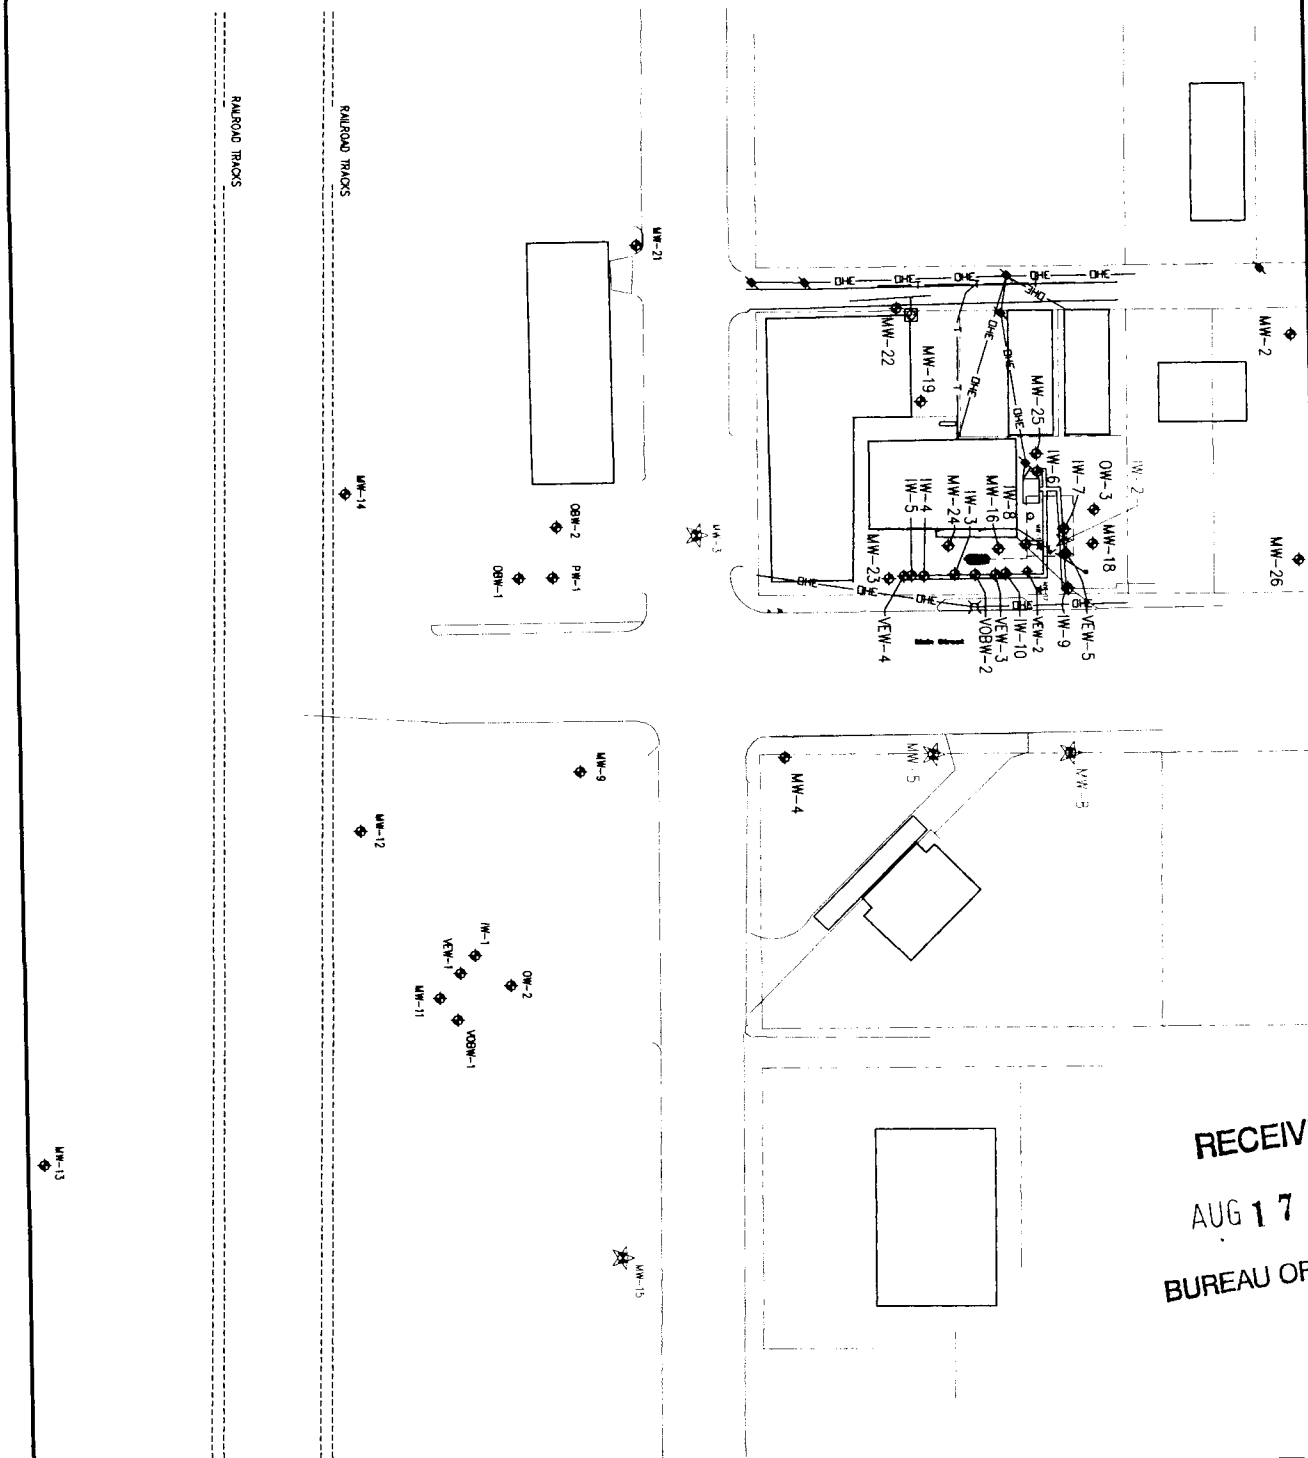

RECEIVED
 AUG 17 2021
 BUREAU OF WATER

LEGEND


- = MONITORING WELL
- = ABANDONED/DESTROYED WELL
- = FORMER PUMP ISLAND & FUEL LINE LOCATION
- = FORMER UNDERGROUND STORAGE TANKS
- = APPROXIMATE ROW LINES
- = FIRE HYDRANT
- = LIGHT POLE
- = POWER POLE
- = WATERMETER
- = GAS METER
- = OVERHEAD ELECTRICAL
- = UNDERGROUND GAS
- = UNDERGROUND ELECTRICAL
- = WATER LINE (ESTIMATED)
- = SIGN

NORTH
 0 31.25 62.5
 SCALE IN FEET

PROJECT NO.	DATE	SCALE
W/20-21-04	MAY 2021	31.25 62.5
FIELD BOOK	DRAWN BY	CHECKED BY
MADA DING	SPENCER	SPENCER
SHEET	FIGURE 1B	

KENSINGTON COOPERATIVE ASSN.
SITE BASE MAP INCLUDING OFF SITE WELLS
 KENSINGTON, KANSAS U6-092-00406

MILCO
 Environmental Services, Inc.
 1000 N. W. 10th St. Suite 200
 Oklahoma City, OK 73102-2800
 Phone: (405) 241-2800
 Fax: (405) 241-2800

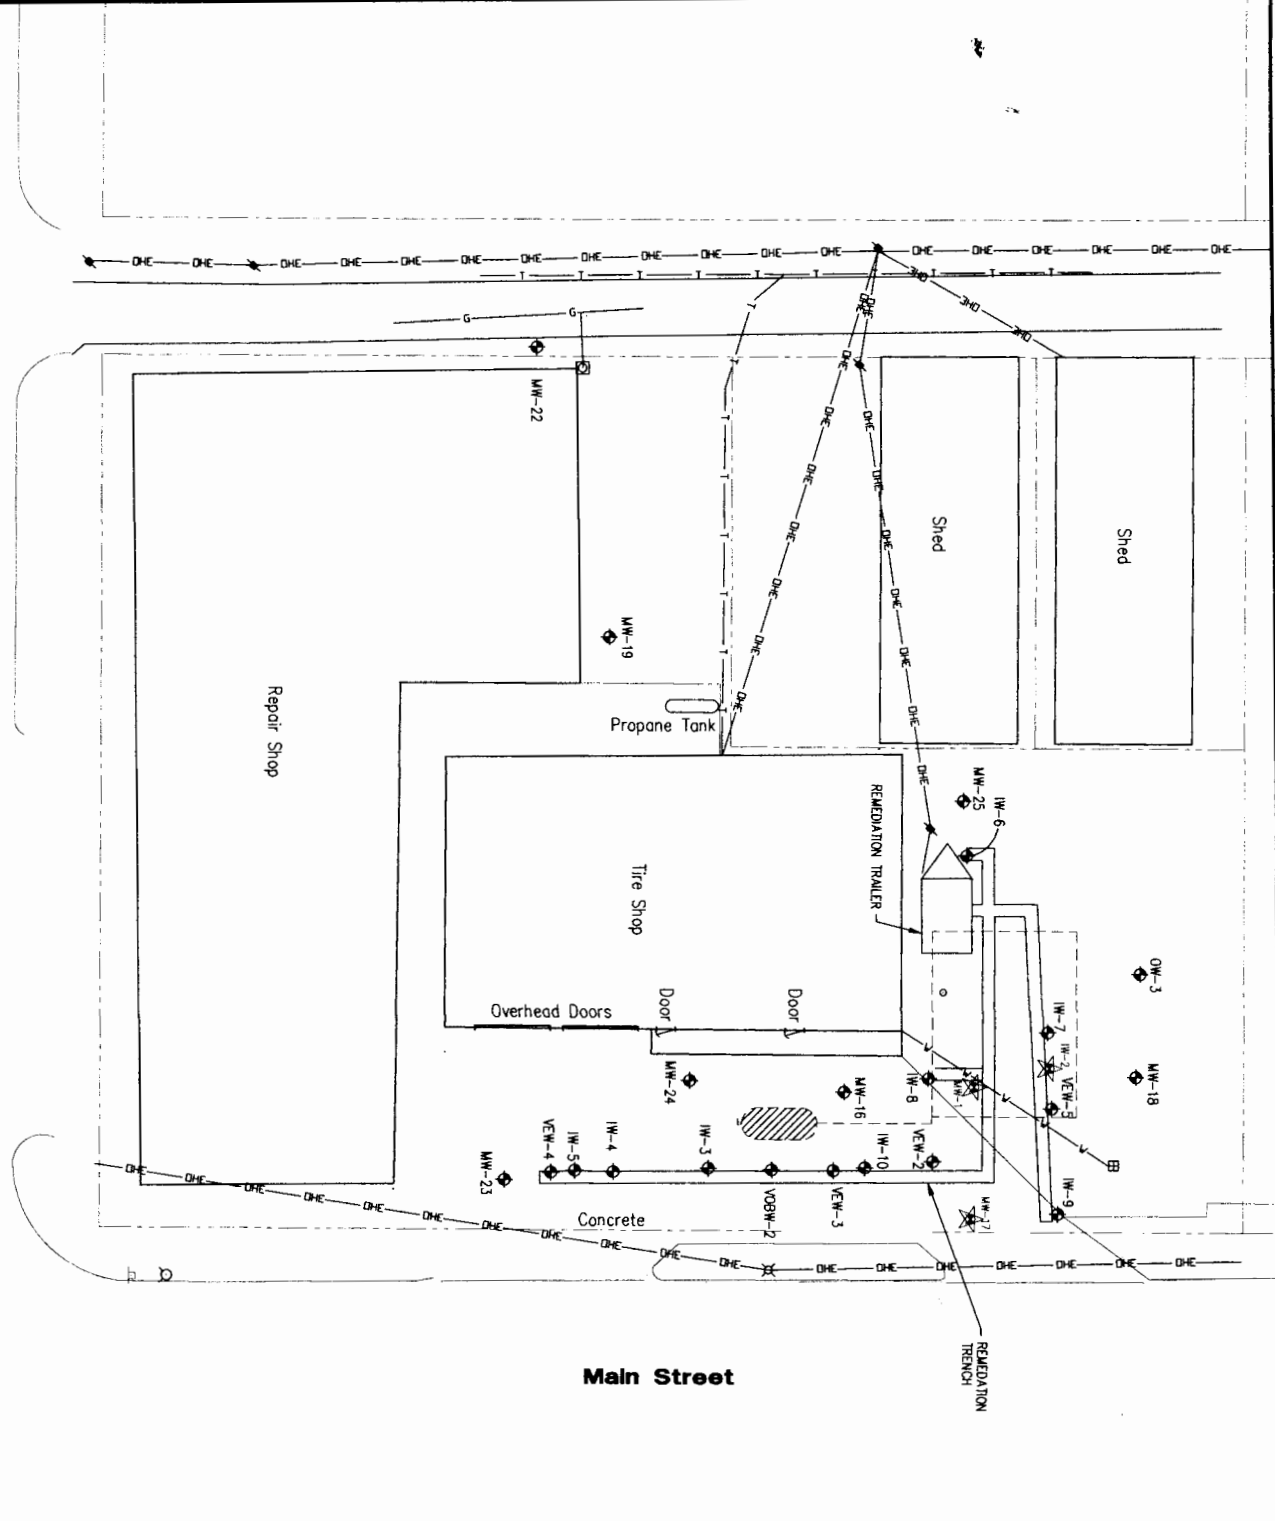


Main Street

LEGEND

- ◆ = MONITORING WELL
- ◆ = ABANDONED/DESTROYED WELL
- ◆ = FORMER & PUMP ISLAND & FUEL LINE LOCATION
- ◆ = STORAGE TANKS
- = APPROXIMATE ROW LINES
- = FIRE HYDRANT
- ⊕ = LIGHT POLE
- ⊖ = POWER POLE
- ⊗ = WATER METER
- ⊞ = GAS METER
- DHE — = OVERHEAD ELECTRICAL
- G — = UNDERGROUND GAS
- T — = UNDERGROUND TELEPHONE
- V — = WATER LINE (ESTIMATE)
- L — = SIGN

NOTE:
SEE FIGURE 1B FOR LOCATION OF
OFF-SITE MONITORING WELLS.

RECEIVED
AUG 17 2021
BUREAU OF WATER

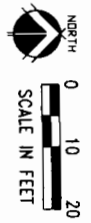

KENSINGTON COOPERATIVE ASSN.
SITE BASE MAP
KENSINGTON, KANSAS U6-092-00406

MILCO
Environmental Services, Inc.
Milco Environmental Services, Inc.
1000 N. 10th St., Suite 100
Kensington, KS 66801-2000
Phone: (785) 860-0888
Fax: (785) 860-0889

SCALE: 1"=20'
PROJECT: MW-19-21-04
DATE: MAY, 2021
FIELD BOOK: 2021-05-01
DRAWN BY: JEROME BT
CHECKED BY: JEROME BT
SCALE: 1"=20'

FIGURE 1

This document, and the ideas and designs incorporated herein, are an intellectual property of MILCO and shall not be used, copied, or in part, for any other project without the written authorization of MILCO.