

WATER WELL RECORD Form WWC-5

Division of Water Resources App. No.

Well ID MW-26

Original Record Correction Change in Well Use

1 LOCATION OF WATER WELL: County: Smith	Fraction NE ¼ SW ¼ SE ¼ NE ¼	Section Number 29	Township Number T 3 S	Range Number R 15 <input type="checkbox"/> E <input checked="" type="checkbox"/> W
--	---------------------------------	-----------------------------	---------------------------------	--

2 WELL OWNER: Last Name: Youngquist First: Newton Business: Address: P.O. Box 21 Address: City: Kensington State: KS ZIP: 66951	Street or Rural Address where well is located (if unknown, distance and direction from nearest town or intersection): If at owner's address, check here: <input type="checkbox"/> 205 S. Main Street, Kensington, KS 66951
--	--

3 LOCATE WELL WITH "X" IN SECTION BOX: N W E S -----1 mile-----	4 DEPTH OF COMPLETED WELL: 50.7 ft. Depth(s) Groundwater Encountered: 1) ft. 2) ft. 3) ft., or 4) <input type="checkbox"/> Dry Well WELL'S STATIC WATER LEVEL: 36.63 ft. <input checked="" type="checkbox"/> below land surface, measured on (mo-day-yr) 5/11/2021 <input type="checkbox"/> above land surface, measured on (mo-day-yr) Pump test data: Well water was ft. after hours pumping gpm Well water was ft. after hours pumping gpm Estimated Yield: gpm Bore Hole Diameter: 8.75 in. to 50.7 ft. and in. to ft.	5 Latitude: 39.76506 (decimal degrees) Longitude: 99.03204 (decimal degrees) Horizontal Datum: <input type="checkbox"/> WGS 84 <input checked="" type="checkbox"/> NAD 83 <input type="checkbox"/> NAD 27 Source for Latitude/Longitude: <input checked="" type="checkbox"/> GPS (unit make/model: EPOCH) (WAAS enabled? <input type="checkbox"/> Yes <input checked="" type="checkbox"/> No) <input type="checkbox"/> Land Survey <input type="checkbox"/> Topographic Map <input type="checkbox"/> Online Mapper: 6 Elevation: 1776.80 ft. <input type="checkbox"/> Ground Level <input checked="" type="checkbox"/> TOC Source: <input checked="" type="checkbox"/> Land Survey <input type="checkbox"/> GPS <input type="checkbox"/> Topographic Map <input type="checkbox"/> Other
--	--	---

7 WELL WATER TO BE USED AS:

1. Domestic: <input type="checkbox"/> Household <input type="checkbox"/> Lawn & Garden <input type="checkbox"/> Livestock	5. <input type="checkbox"/> Public Water Supply: well ID 6. <input type="checkbox"/> Dewatering: how many wells? 7. <input type="checkbox"/> Aquifer Recharge: well ID 8. <input checked="" type="checkbox"/> Monitoring: well ID MW-26 9. Environmental Remediation: well ID	10. <input type="checkbox"/> Oil Field Water Supply: lease 11. Test Hole: well ID <input type="checkbox"/> Cased <input type="checkbox"/> Uncased <input type="checkbox"/> Geotechnical 12. Geothermal: how many bores? a) Closed Loop <input type="checkbox"/> Horizontal <input type="checkbox"/> Vertical b) Open Loop <input type="checkbox"/> Surface Discharge <input type="checkbox"/> Inj. of Water 13. <input type="checkbox"/> Other (specify):
--	--	---

Was a chemical/bacteriological sample submitted to KDHE? Yes No If yes, date sample was submitted:

Water well disinfected? Yes No

8 TYPE OF CASING USED: Steel PVC Other CASING JOINTS: Glued Clamped Welded Threaded
Casing diameter **2** in. to **30.7** ft., Diameter in. to ft., Diameter in. to ft.
Casing height above land surface **-6** in. Weight lbs./ft. Wall thickness or gauge No.

TYPE OF SCREEN OR PERFORATION MATERIAL:
 Steel Stainless Steel Fiberglass PVC Other (Specify)
 Brass Galvanized Steel Concrete tile None used (open hole)

SCREEN OR PERFORATION OPENINGS ARE:
 Continuous Slot Mill Slot Gauze Wrapped Torch Cut Drilled Holes Other (Specify)
 Louvered Shutter Key Punched Wire Wrapped Saw Cut None (Open Hole)

SCREEN-PERFORATED INTERVALS: From **30.7** ft. to **50.7** ft., From ft. to ft., From ft. to ft.
GRAVEL PACK INTERVALS: From **28** ft. to **50.7** ft., From ft. to ft., From ft. to ft.

9 GROUT MATERIAL: Neat cement Cement grout Bentonite Other
Grout Intervals: From **1** ft. to **28** ft., From ft. to ft., From ft. to ft.


Nearest source of possible contamination:
 Septic Tank Lateral Lines Pit Privy Livestock Pens Insecticide Storage
 Sewer Lines Cess Pool Sewage Lagoon Fuel Storage Abandoned Water Well
 Watertight Sewer Lines Seepage Pit Feedyard Fertilizer Storage Oil Well/Gas Well
 Other (Specify)

Direction from well? **S** Distance from well? **70** ft.

10 FROM	TO	LITHOLOGIC LOG	FROM	TO	LITHO. LOG (cont.) or PLUGGING INTERVALS
0	5	Clayey Silt			
5	11.5	Silt			
11.5	17	Silty Clay			
17	25	Sand			
25	30	Sandy Silty			
30	36	Sand			
36	41	Silty Clay			
41	45	Sand			
45	50.7	Sand with Clay			

Notes:
Kensington Cooperative Assn. KDHE BER Project Code: U6-092-00406

11 CONTRACTOR'S OR LANDOWNER'S CERTIFICATION: This water well was constructed, reconstructed, or plugged under my jurisdiction and was completed on (mo-day-year) **5/12/2020**..... and this record is true to the best of my knowledge and belief. Kansas Water Well Contractor's License No. **694**..... This Water Well Record was completed on (mo-day-year) **7/19/2021**..... under the business name of **Environmental Priority Service**..... Signature **[Signature]**.....

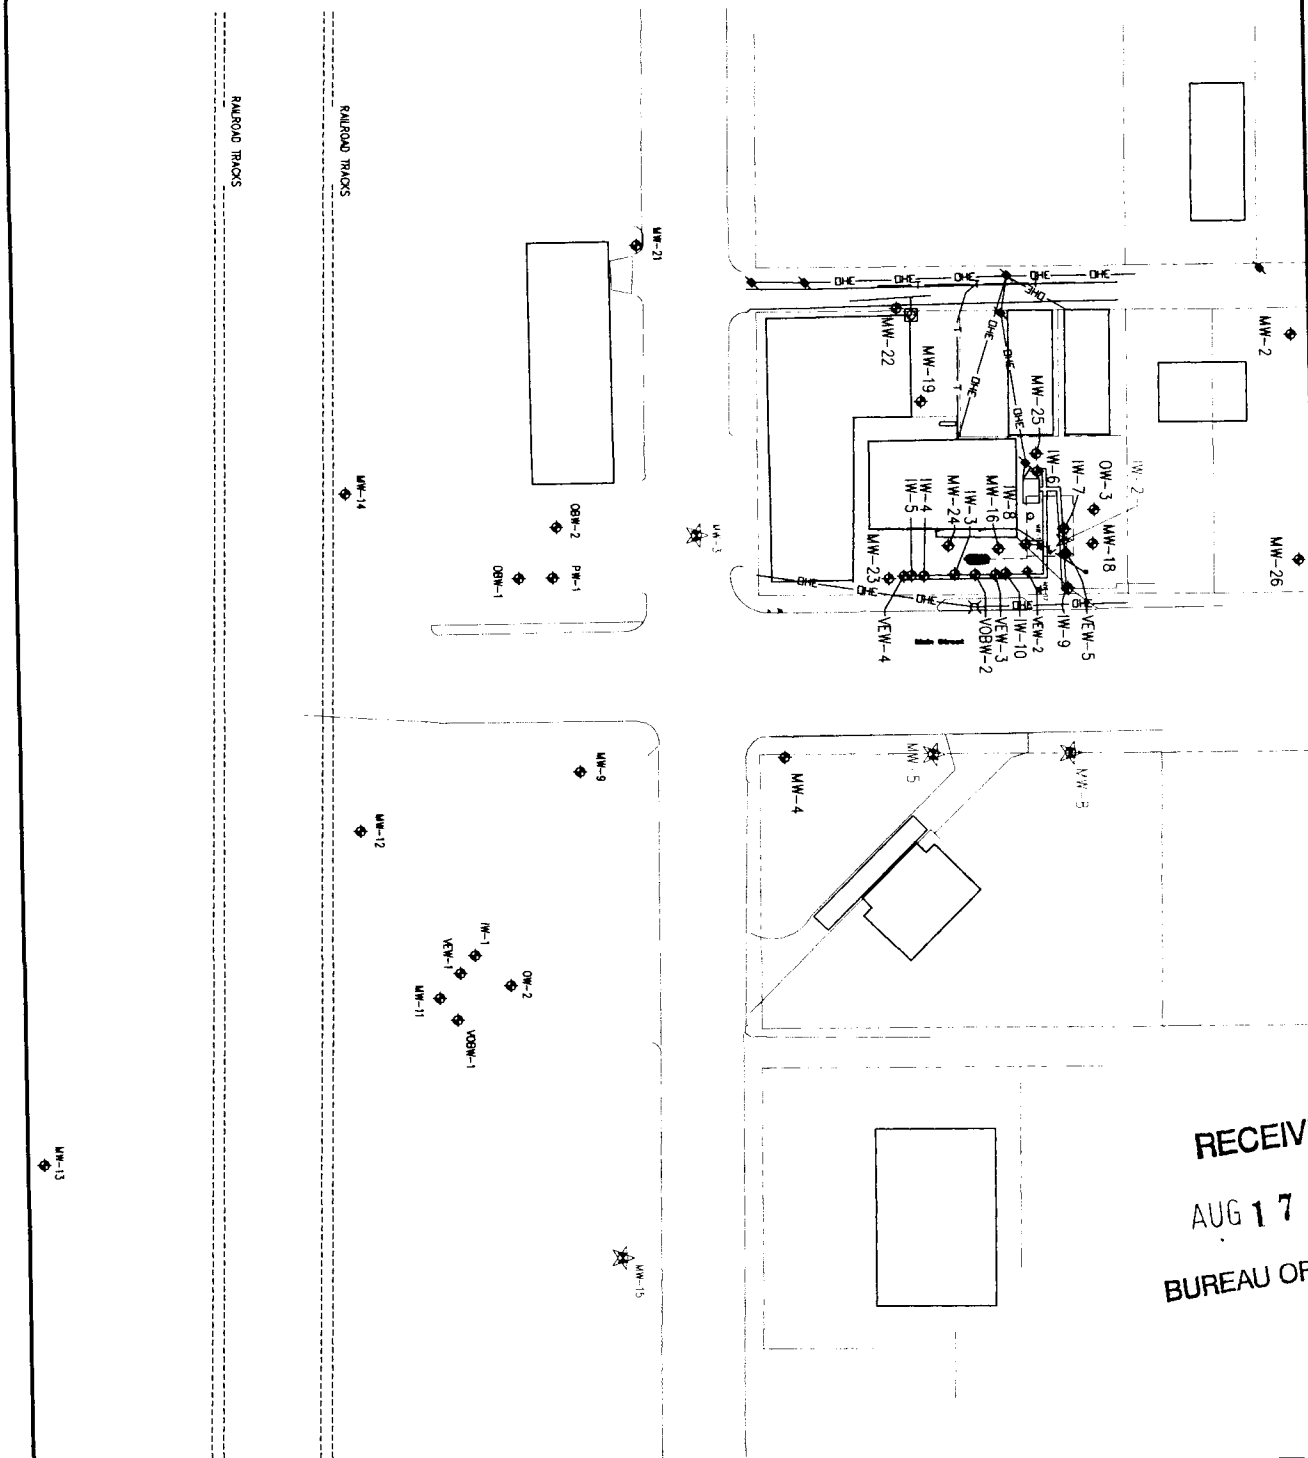

RECEIVED
 AUG 17 2021
 BUREAU OF WATER

LEGEND

- = ABANDONED/DESTROYED WELL
- = FORMER & PUMP ISLAND & FUEL LINE LOCATION
- = FORMER UNDERGROUND STORAGE TANKS
- = APPROXIMATE ROW LINES
- = MONITORING WELL
- = FIRE HYDRANT
- = LIGHT POLE
- = POWER POLE
- = WATERMETER
- = GAS METER
- = OVERHEAD ELECTRICAL
- = UNDERGROUND GAS
- = UNDERGROUND TELEPHONE
- = WATER LINE (ESTIMATED)
- = SIGN


NORTH

0 31.25 62.5
 SCALE IN FEET

PROJECT NO.	DATE	SCALE
W/20-21-04	MAY 2021	0 31.25 62.5
DRAWN BY:	CHECKED BY:	DATE
SP	SP	
FIGURE 1B		

KENSINGTON COOPERATIVE ASSN.
SITE BASE MAP INCLUDING OFF SITE WELLS
 KENSINGTON, KANSAS U6-092-00406

MILCO
 Environmental Services, Inc.
 1000 N. W. 10th St., Suite 200
 Oklahoma City, OK 73102-1000
 Phone: (405) 241-2422
 Fax: (405) 241-2423

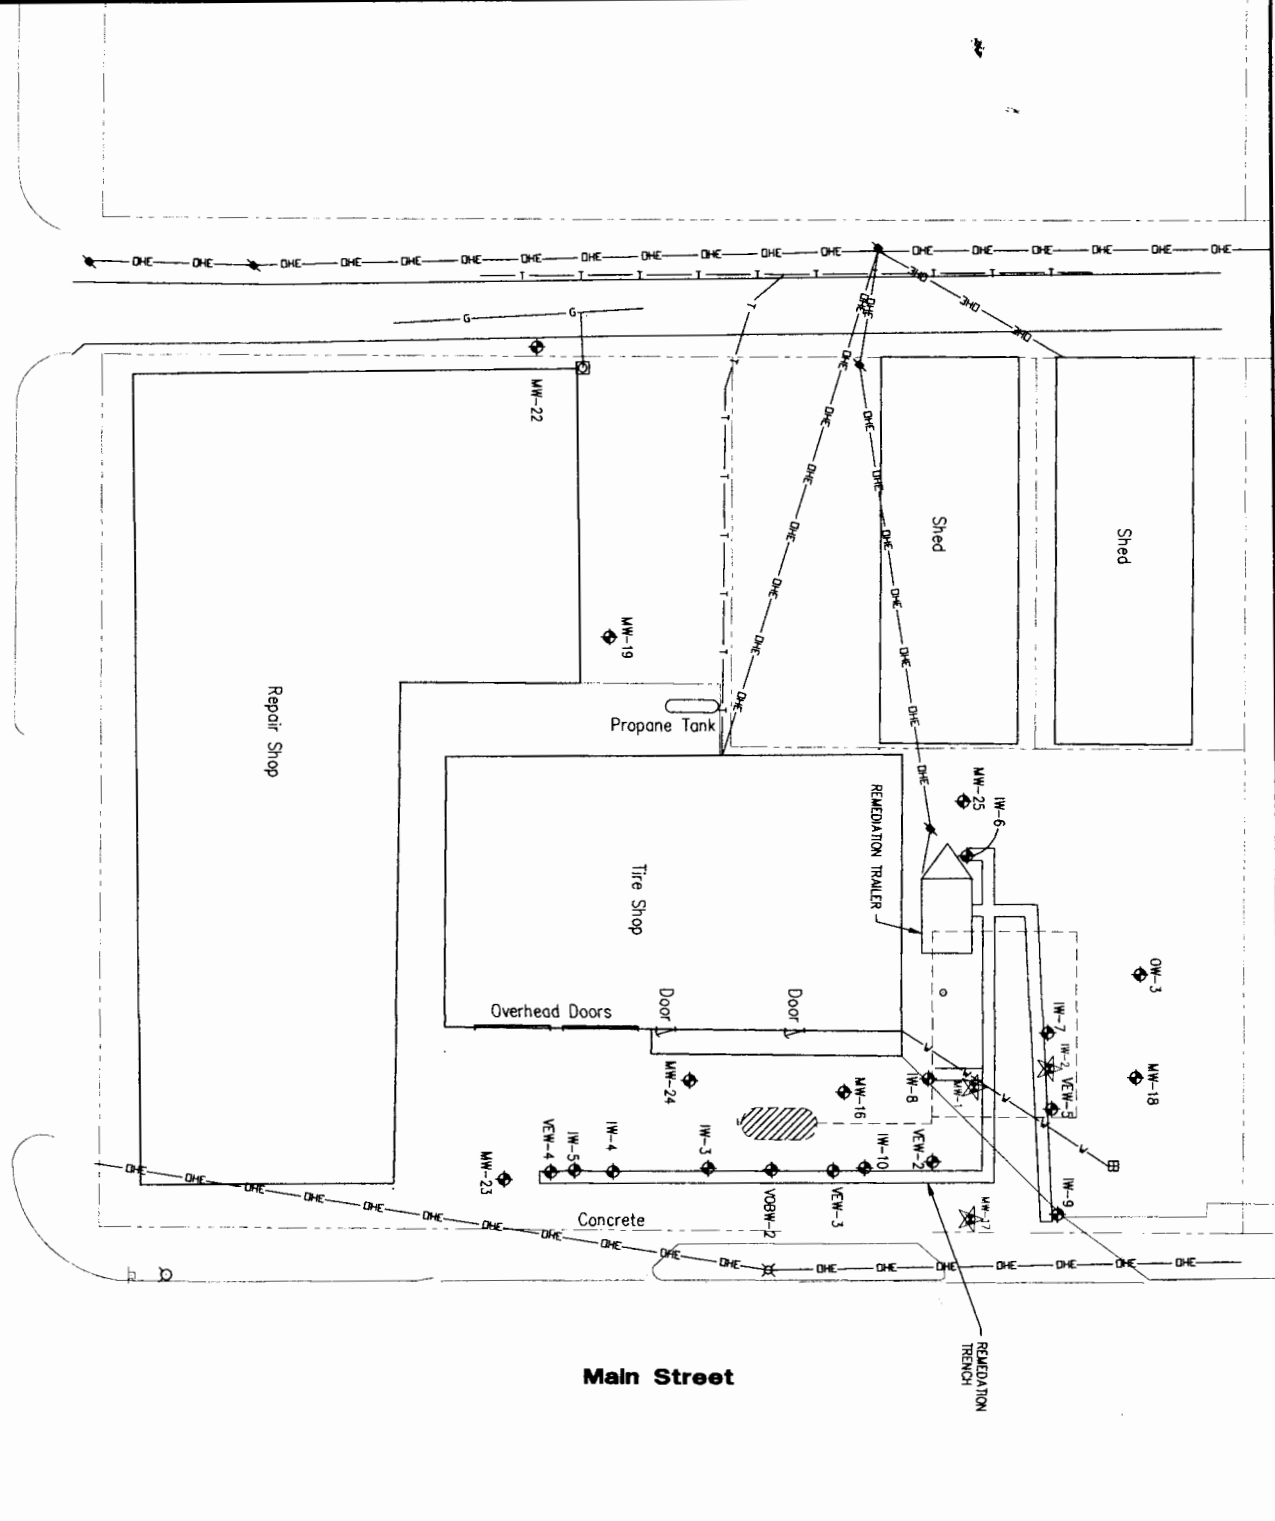


Main Street

LEGEND

- ◆ = MONITORING WELL
- ◆ = ABANDONED/DESTROYED WELL
- ◆ = FORMER & PUMP ISLAND & FUEL LINE LOCATION
- = STORAGE TANKS
- = APPROXIMATE ROW LINES
- = FIRE HYDRANT
- ⊗ = LIGHT POLE
- ⊖ = POWER POLE
- ⊕ = WATER METER
- ⊗ = GAS METER
- = OVERHEAD ELECTRICAL
- = UNDERGROUND GAS
- = UNDERGROUND TELEPHONE
- = WATER LINE (ESTIMATE)
- = SIGN

NOTE:
SEE FIGURE 1B FOR LOCATION OF
OFF-SITE MONITORING WELLS.

RECEIVED
AUG 17 2021
BUREAU OF WATER

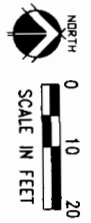

KENSINGTON COOPERATIVE ASSN.
SITE BASE MAP
KENSINGTON, KANSAS U6-092-00406

MILCO
Environmental Services, Inc.
Milco Environmental Services, Inc.
1000 N. 10th St., Suite 100
Kensington, KS 66801-2000
Phone: (785) 860-0888
Fax: (785) 860-0889

SCALE: 1" = 20'

PROJECT: MW-19-21-04

DATE: MAY, 2021

FIELD SKETCH: []

DESIGN: []

SCALE: []

FIGURE 1

The drawings, and the ideas and design incorporated herein, are an invention of professional service, the property of MILCO and shall not be used or copied, in part or in full, for any other project without the written authorization of © 2000 MILCO.