

WATER WELL RECORD Form WWC-5

Division of Water Resources App. No.

Well ID IW-8

Original Record Correction Change in Well Use

1 LOCATION OF WATER WELL: County: Smith Fraction NE 1/4 SW 1/4 SE 1/4 NE 1/4 Section Number 29 Township Number T 3 S Range Number R 15 E W

2 WELL OWNER: Last Name: Struckhoff First: Cory Street or Rural Address where well is located (if unknown, distance and direction from nearest town or intersection): If at owner's address, check here: 223 S. Main Street, Kensington, KS 66951

3 LOCATE WELL WITH "X" IN SECTION BOX: N W E S 1 mile

4 DEPTH OF COMPLETED WELL: 52.7 ft. Depth(s) Groundwater Encountered: 1) ... ft. 2) ... ft. 3) ... ft., or 4) Dry Well WELL'S STATIC WATER LEVEL: 35.63 ft. below land surface, measured on (mo-day-yr) 5/11/2021

5 Latitude: 39.76469 (decimal degrees) Longitude: 99.03207 (decimal degrees) Horizontal Datum: WGS 84 NAD 83 NAD 27 Source for Latitude/Longitude: GPS (unit make/model: EPOCH) (WAAS enabled? Yes No) Land Survey Topographic Map Online Mapper

6 Elevation: 1775.63 ft. Ground Level TOC Source: Land Survey GPS Topographic Map Other

7 WELL WATER TO BE USED AS: 1. Domestic: Household Lawn & Garden Livestock Irrigation Feedlot Industrial 5. Public Water Supply: well ID 6. Dewatering: how many wells? 7. Aquifer Recharge: well ID 8. Monitoring: well ID 9. Environmental Remediation: well ID IW-8 Air Sparge Soil Vapor Extraction Recovery Injection 10. Oil Field Water Supply: lease 11. Test Hole: well ID Cased Uncased Geotechnical 12. Geothermal: how many bores? a) Closed Loop Horizontal Vertical b) Open Loop Surface Discharge Inj. of Water 13. Other (specify):


Was a chemical/bacteriological sample submitted to KDHE? Yes No If yes, date sample was submitted: Water well disinfected? Yes No

8 TYPE OF CASING USED: Steel PVC Other CASING JOINTS: Glued Clamped Welded Threaded Casing diameter 2 in. to 48.0 ft., Diameter 2 in. to 50.5-52.7 ft., Diameter in. to ft. Casing height above land surface -6 in. Weight lbs./ft. Wall thickness or gauge No. TYPE OF SCREEN OR PERFORATION MATERIAL: Steel Stainless Steel Fiberglass PVC Other (Specify) Brass Galvanized Steel Concrete tile None used (open hole) SCREEN OR PERFORATIONS ARE: Continuous Slot Mill Slot Gauze Wrapped Torch Cut Drilled Holes Other (Specify) Louvered Shutter Key Punched Wire Wrapped Saw Cut None (Open Hole) SCREEN-PERFORATED INTERVALS: From 48.0 ft. to 50.5 ft., From ft. to ft., From ft. to ft. GRAVEL PACK INTERVALS: From 45.2 ft. to 52.7 ft., From ft. to ft., From ft. to ft.

9 GROUT MATERIAL: Neat cement Cement grout Bentonite Other sand and silt of remedial trench above 4.2 Grout Intervals: From 4.2 ft. to 45.2 ft., From ft. to ft., From ft. to ft. Nearest source of possible contamination: Septic Tank Lateral Lines Pit Privy Livestock Pens Insecticide Storage Sewer Lines Cess Pool Sewage Lagoon Fuel Storage Abandoned Water Well Watertight Sewer Lines Seepage Pit Feedyard Fertilizer Storage Oil Well/Gas Well Other (Specify) Direction from well? at source Distance from well? ft.

Table with 6 columns: FROM, TO, LITHOLOGIC LOG, FROM, TO, LITHO. LOG (cont.) or PLUGGING INTERVALS. Rows include Silty Clay, Silt, Silty Clay, Sandy Silt, Sand, Silty Clay with sand, Sand, Clayey Sand. Notes: Kensington Cooperative Assn. KDHE BER Project Code: U6-092-00406

11 CONTRACTOR'S OR LANDOWNER'S CERTIFICATION: This water well was constructed, reconstructed, or plugged under my jurisdiction and was completed on (mo-day-year) 4/22/2021 and this record is true to the best of my knowledge and belief. Kansas Water Well Contractor's License No. 604 This Water Well Record was completed on (mo-day-year) 7/19/2021 under the business name of Environmental Priority Service Signature P. H. M. E.

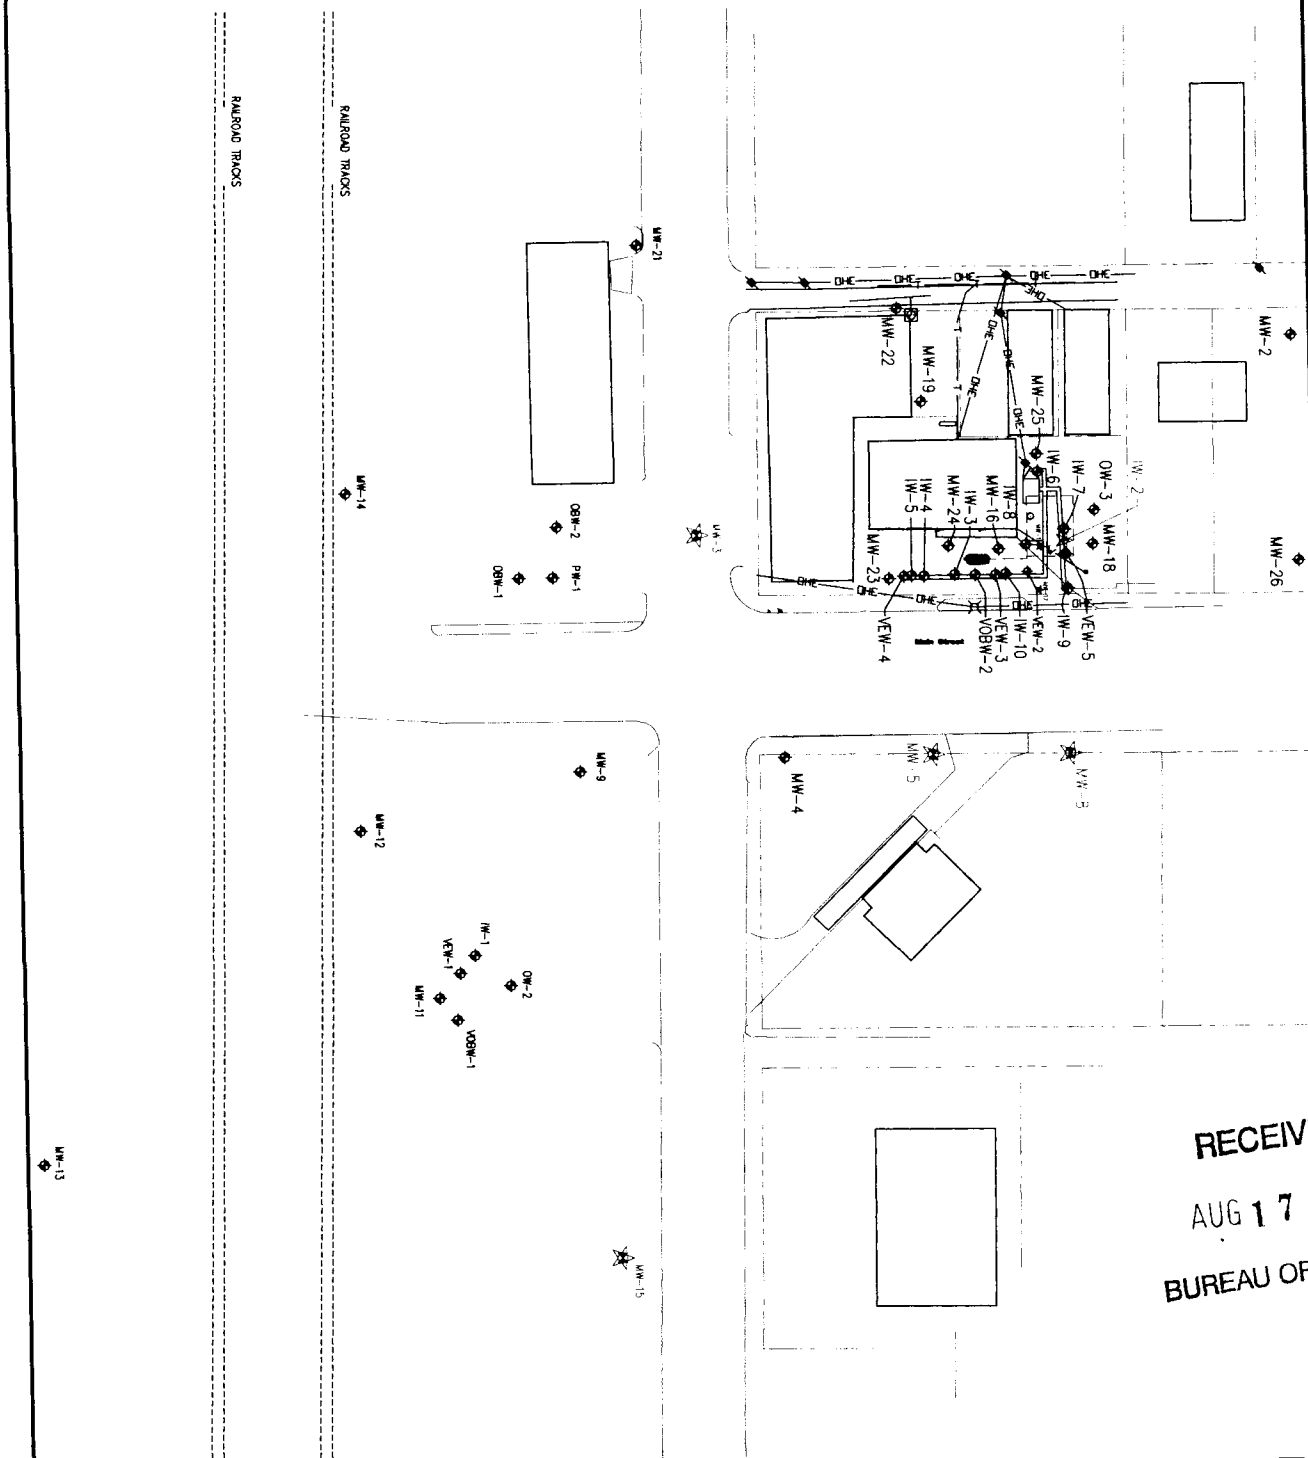

RECEIVED  
 AUG 17 2021  
 BUREAU OF WATER

**LEGEND**

- = MONITORING WELL
- = ABANDONED/DESERTED WELL
- = FORMER PUMP ISLAND & FUEL LINE LOCATION
- = FORMER UNDERGROUND STORAGE TANKS
- = APPROXIMATE ROW LINES
- = FIRE HYDRANT
- = LIGHT POLE
- = POWER POLE
- = WATERMETER
- = GAS METER
- = OVERHEAD ELECTRICAL
- = UNDERGROUND GAS
- = UNDERGROUND TELEPHONE
- = WATER LINE (ESTIMATED)
- = SIGN


NORTH  
 0 31.25 62.5  
 SCALE IN FEET

PROJECT NO.	DATE	SCALE
W/20-21-04	MAY 2021	1" = 31.25'
DRAWN BY:	CHECKED BY:	DATE:
SPR	SPR	7/19/21

**KENSINGTON COOPERATIVE ASSN.**  
**SITE BASE MAP INCLUDING OFF SITE WELLS**  
 KENSINGTON, KANSAS U6-092-00406

**MILCO**  
 Environmental Services, Inc.  
 1000 N. W. 120th St., Suite 200  
 Oklahoma City, OK 73160  
 Phone: (405) 761-8800  
 Fax: (405) 761-8801

This document and the design it represents remain the property of MILCO and shall not be used or copied in any other project without the written authorization of MILCO.

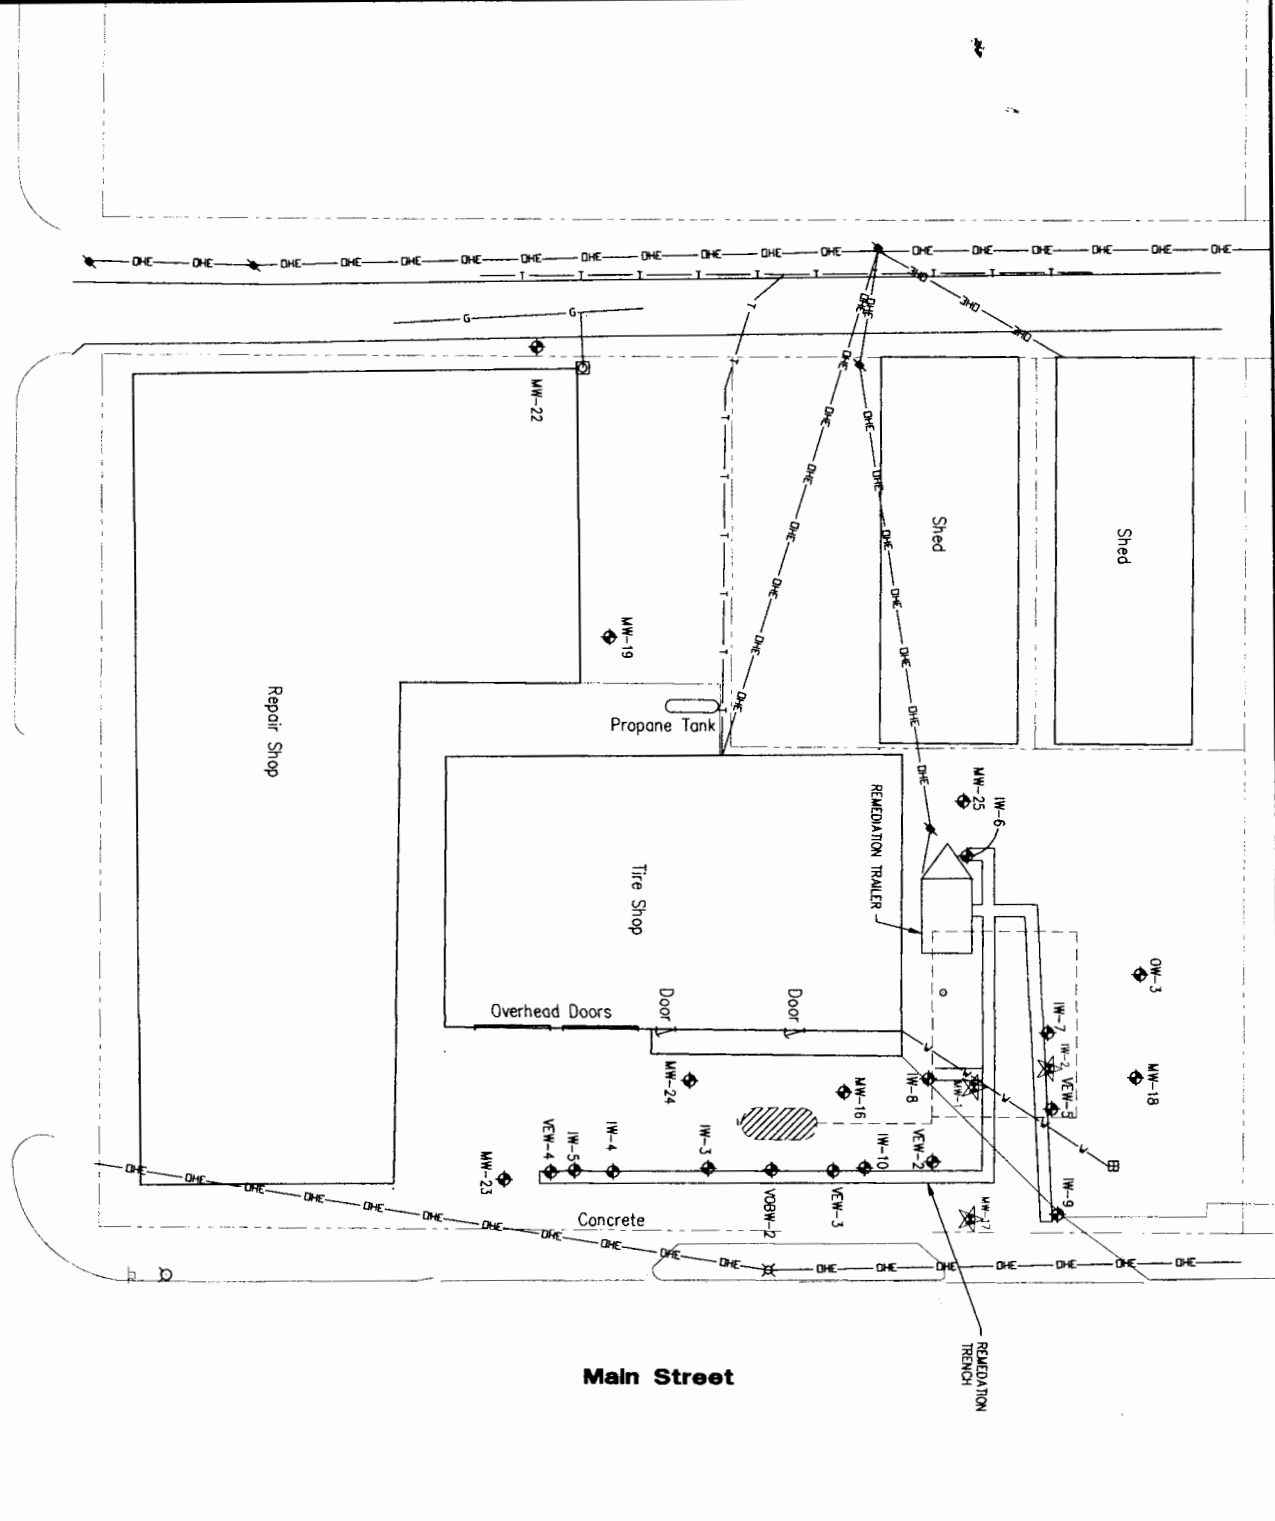


Main Street

**LEGEND**

- ◆ = MONITORING WELL
- ◆ = ABANDONED/DESTROYED WELL
- ◆ = FORMER & PUMP ISLAND & FUEL LINE LOCATION
- = FORMER UNDERGROUND STORAGE TANKS
- = APPROXIMATE ROW LINES
- = FIRE HYDRANT
- ⊗ = LIGHT POLE
- ⊕ = POWER POLE
- ⊖ = WATER METER
- ⊗ = GAS METER
- = OVERHEAD ELECTRICAL
- = UNDERGROUND GAS
- = UNDERGROUND TELEPHONE
- = WATER LINE (ESTIMATE)
- ⊖ = SIGN

NOTE:  
SEE FIGURE 1B FOR LOCATION OF  
OFF-SITE MONITORING WELLS.

RECEIVED  
AUG 17 2021  
BUREAU OF WATER

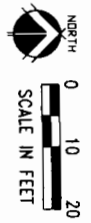

KENSINGTON COOPERATIVE ASSN.  
**SITE BASE MAP**  
KENSINGTON, KANSAS U6-092-00406

**MILCO**  
Environmental Services, Inc.  
Milco Environmental Services, Inc.  
1000 N. 10th St., Suite 100  
Kensington, KS 66801-2000  
Phone: (785) 860-0888  
Fax: (785) 860-0889

SCALE: 1"=20'

PROJECT: MW-19-21-04

DATE: MAY, 2021

FIELD SKETCH: [ ]

DESIGN: [ ]

SCALE: [ ]

FIGURE 1

The drawings and the ideas and design incorporated herein, as an instrument of professional service, are the property of MILCO and shall not be used, in whole or in part, for any other project without the written authorization of © 2000 MILCO.