

WATER WELL RECORD Form WWC-5

Original Record Correction Change in Well Use

Division of Water Resources App. No.

Well ID

1 LOCATION OF WATER WELL: County: Phillips Fraction: SE 1/4 SW 1/4 SE 1/4 NW 1/4 Section Number: 27 Township Number: T 3 S Range Number: R 10 E X W

2 WELL OWNER: Last Name: USDA First: CCC Street or Rural Address where well is located: North of Coop Grain Elevators

3 LOCATE WELL WITH 'X' IN SECTION BOX: N W E S

4 DEPTH OF COMPLETED WELL: 63 ft. Depth(s) Groundwater Encountered: 1) ... ft. 2) ... ft. 3) ... ft. or 4) Dry Well

5 Latitude: N 39.7638869 Longitude: W 99.1172830 Horizontal Datum: WGS 84 NAD 83 NAD 27

7 WELL WATER TO BE USED AS: 1. Domestic: Household Lawn & Garden Livestock 2. Irrigation 3. Feedlot 4. Industrial

Was a chemical/bacteriological sample submitted to KDHE? Yes No If yes, date sample was submitted:

8 TYPE OF CASING USED: Steel PVC Other CASING JOINTS: Glued Clamped Welded Threaded Casing diameter: 8 in. to 5.3 ft.

9 GROUT MATERIAL: Neat cement Cement grout Bentonite Other Grout Intervals: From 7 ft. to 30 ft.

Nearest source of possible contamination: Septic Tank Lateral Lines Pit Privy Livestock Pens Insecticide Storage

10 FROM TO LITHOLOGIC LOG FROM TO LITHO. LOG (cont.) or PLUGGING INTERVALS

11 CONTRACTOR'S OR LANDOWNER'S CERTIFICATION: This water well was constructed, reconstructed, or plugged under my jurisdiction and was completed on (mo-day-year) 10/14/2021

Division of Environment
Curtis State Office Building
1000 SW Jackson St., Suite 400
Topeka, KS 66612-1367



Phone: 785-296-1535
Fax: 785-559-4264
www.kdheks.gov

Lee A. Norman, M.D., Secretary

Laura Kelly, Governor

October 5, 2021

Lawrence Erdman, Operations Manager
Cascade
301 Alderson St.
Schofield, WI 54476

Subject: Monitoring Well Flush-Mount Waiver Request for Pro-Ag Co-op Site, 671 Railroad Ave., Agra, Phillips County, Kansas, SE, SW, SE, NW, Sec. 27, T. 3S, R. 16W. KDHE Project Code C6-074-72376

Dear Mr. Erdman,

Today, the Kansas Department of Health and Environment, Bureau of Water, Geology & Well Technology Unit (KDHE), received the above referenced request to convert three (3) extraction wells to flush-mount surface completions at the above referenced site and location. The wellhead completions will be made by Kansas licensed water well contractor Cascade Drilling, (Lic. #597), due to the presence of heavy equipment operating in the immediate area and to close proximity of railroad tracks. The environmental remediation wells are part of ongoing groundwater remediation and monitoring activities at the site.

Waiver request materials included an email request with required information, site figure confirming well locations, and flush-mount well completion diagram to be followed in accordance with the *KDHE Flush-Mount Well Construction Detail* dated January 2018.

KDHE has reviewed the waiver request materials, with this letter provides notice of approval for conversion of three above-ground completion extraction wells to at-grade completion at the above referenced site.

As required in KDHE's Procedure *WWP-5 – Procedure for Requesting a Waiver to Allow Installation of a Flush-Mount Monitoring Well*, the location, well number, and latitude/longitude coordinates with associated horizontal datum must be shown in a scaled map and provided to KDHE along with the water well records (WWC-5 Forms) indicating that these wells have been reconstructed in accordance with Article 30 - K.A.R. 28-30-6(s). Please plan to attach such a map with the WWC-5 forms.


Please contact me at 785-296-3565 (office), 785-224-5259 (work cell), or Pam.Chaffee@ks.gov if you have any questions or need further assistance.

Sincerely,

A handwritten signature in blue ink that reads "Pamela Chaffee".

Pamela Chaffee, P.G.
Water Well Program Manager
Geology & Well Technology Unit/Bureau of Water
1000 SW Jackson St, Suite 420
Topeka, KS 66612-1367

Copy: File – BOW/GWTU – Phillips County
Sitney Day, KDHE/BER/Remedial Section, Site Restoration Unit Project Manager

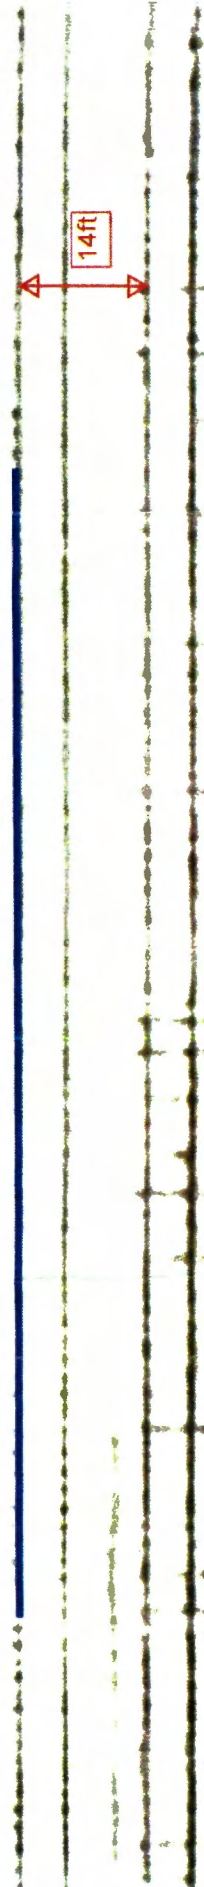

MW-J