

WATER WELL RECORD Form WWC-5

Division of Water Resources App. No.

CMW2

Original Record Correction Change in Well Use

Well ID

1 LOCATION OF WATER WELL: County: CLOUD Fraction SE 1/4 SW 1/4 NW 1/4 SE 1/4 Section Number 33 Township Number T 5 S Range Number R 3 E W

2 WELL OWNER: Last Name: Business: KDHE-BER Address: 1000 SW JACKSON City: TOPEKA State: KS ZIP: 66612-1367 Street or Rural Address where well is located: 211 E 7TH ST., CONCORDIA

3 LOCATE WELL WITH 'X' IN SECTION BOX: N W E S 1 mile. 4 DEPTH OF COMPLETED WELL: 35 ft. 5 Latitude: 39.57074 Longitude: 97.65726

7 WELL WATER TO BE USED AS: 1. Domestic: 2. Irrigation 3. Feedlot 4. Industrial 5. Public Water Supply 6. Dewatering 7. Aquifer Recharge 8. Monitoring 9. Environmental Remediation 10. Oil Field Water Supply 11. Test Hole 12. Geothermal 13. Other

Was a chemical/bacteriological sample submitted to KDHE? Water well disinfected?

8 TYPE OF CASING USED: 2 in. to 35 ft. Diameter. TYPE OF SCREEN OR PERFORATION MATERIAL: Mill Slot. SCREEN OR PERFORATION OPENINGS ARE: Mill Slot. SCREEN-PERFORATED INTERVALS: 20 ft. to 35 ft. GRAVEL PACK INTERVALS: 18 ft. to 35 ft.


9 GROUT MATERIAL: Neat cement. Grout Intervals: 1 ft. to 18 ft. Nearest source of possible contamination: EAST. Direction from well? EAST. Distance from well? 65 ft.

Table with columns: 10 FROM, TO, LITHOLOGIC LOG, FROM, TO, LITHO. LOG (cont.) or PLUGGING INTERVALS. Rows: 0-5 CONCRETE, 5-35 SILTY CLAY (CL). Includes Notes: U5-015-15097

11 CONTRACTOR'S OR LANDOWNER'S CERTIFICATION: This water well was constructed, reconstructed, or plugged under my jurisdiction and was completed on (mo-day-year) 6/24/19 and this record is true to the best of my knowledge and belief.

Cloud

33-T5-R3W

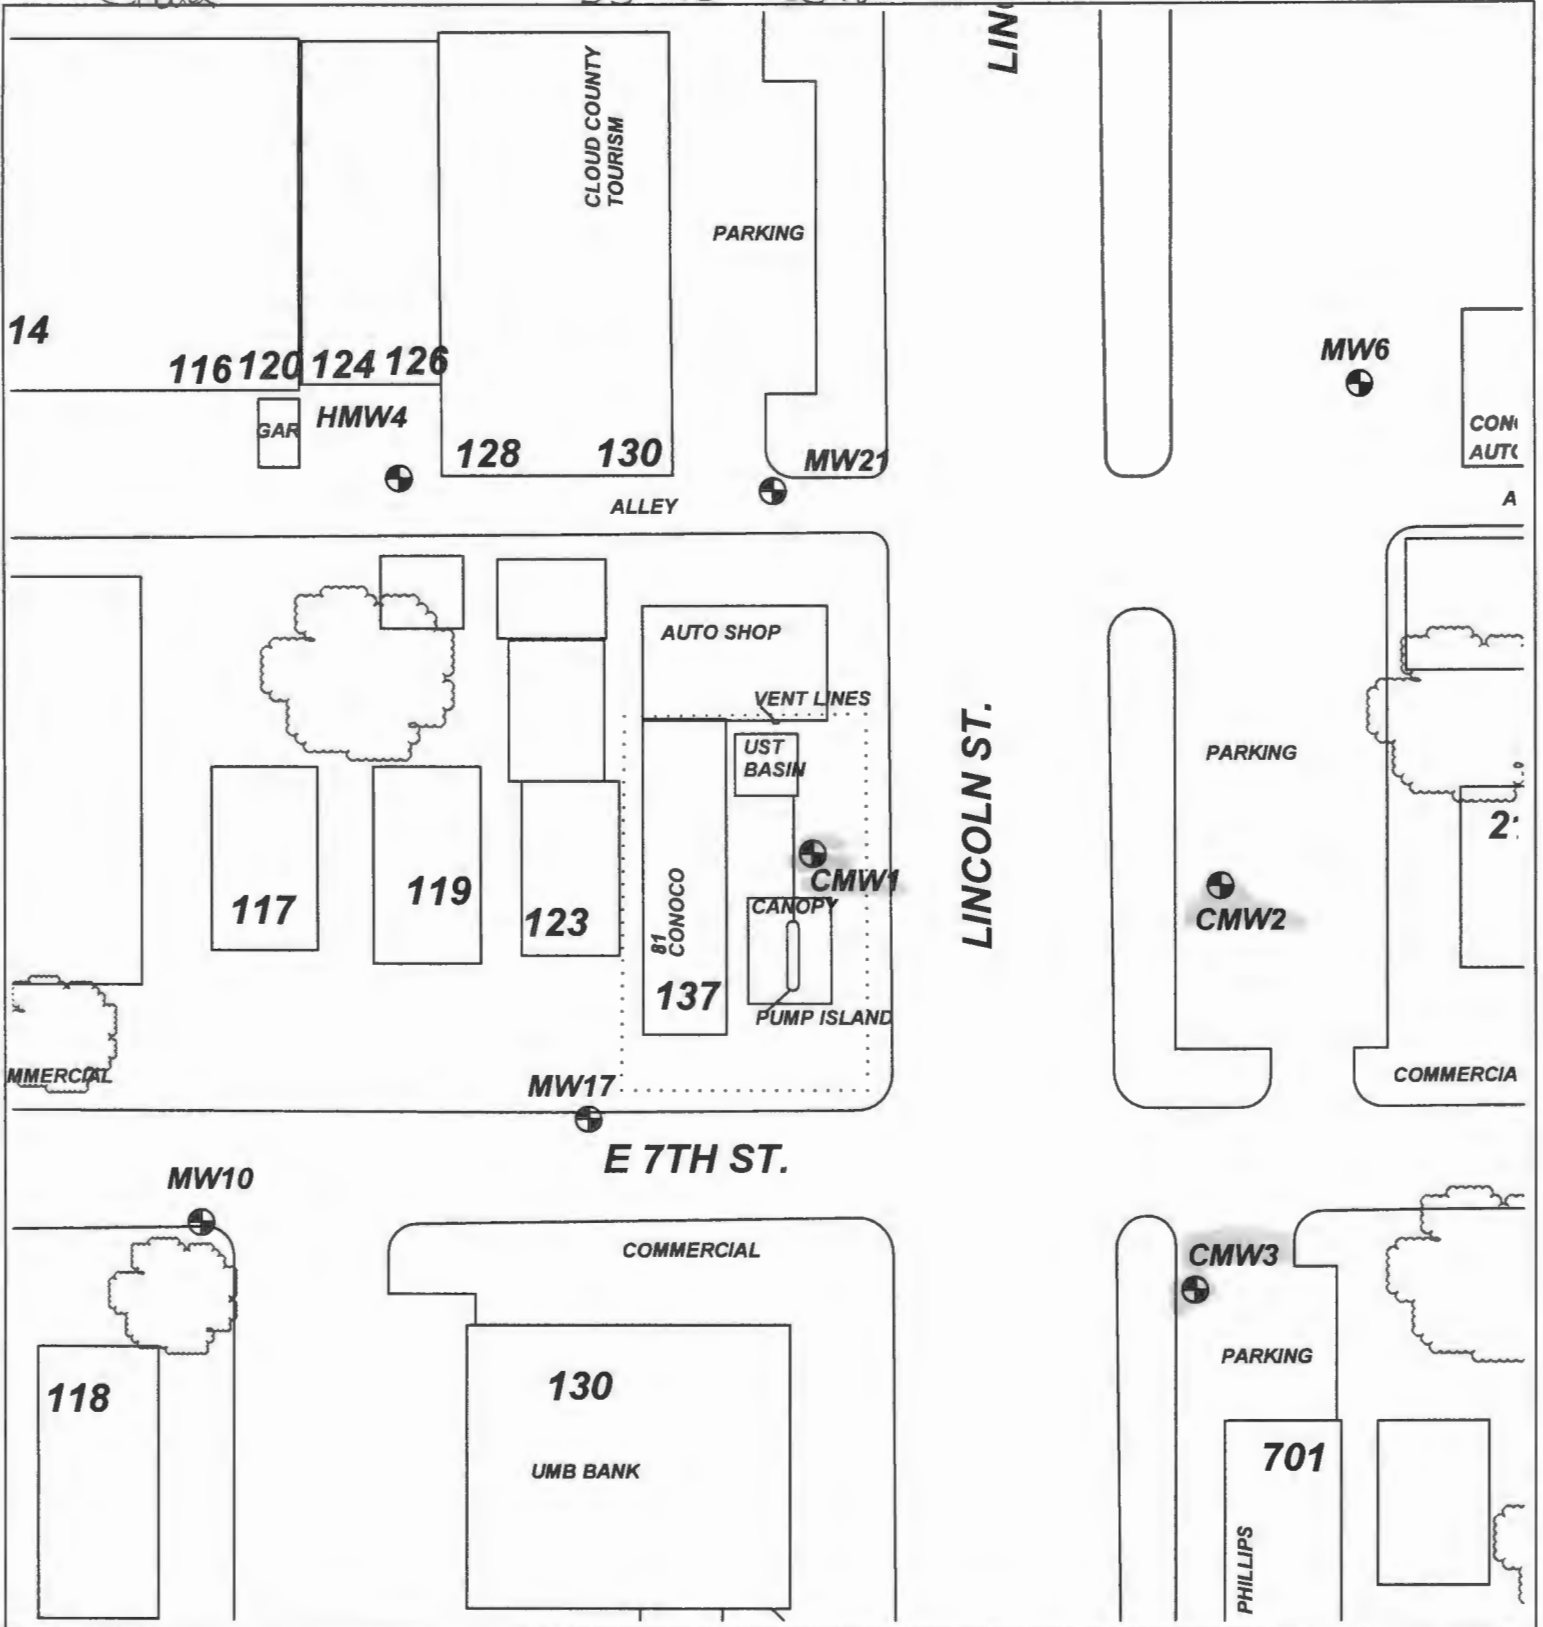

PROJECT: **81 CONOCO**

ADDRESS: **137 EAST 7TH**

LOCATION: **CONCORDIA, KS**

DRAWN BY: **B. JOHNSON** DATE: **7/13/18**

REVISED BY: **B. STALNAKER** DATE: **7/29/19**


AEI JOB #: **TM240** KDHJE JOB #: **U5-015-15097**

TITLE:

AEI ASSOCIATED ENVIRONMENTAL INC.

LEGEND:

- = UST Basin; 1-4,000 gal & 1-6,000 gal gasoline USTs
- = CONCORDIA CITY HALL/MURK AUTOMOTIVE U5-015-10390/U5-015-00219
- = HAIRISCOPE MONITORING WELL LOCATION
- = SUBJECT PROPERTY

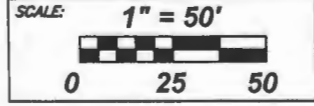

NOTES:
No basements observed within 500'.