

WATER WELL RECORD Form WWC-5

Division of Water Resources App. No.

CMW3

Original Record Correction Change in Well Use

Well ID

1 LOCATION OF WATER WELL: County: CLOUD Fraction SE 1/4 SW 1/4 NW 1/4 SE 1/4 Section Number 33 Township Number T 5 S Range Number R 3 E W

2 WELL OWNER: Last Name: KDHE-BER Business: KDHE-BER Address: 1000 SW JACKSON City: TOPEKA State: KS ZIP: 66612-1367 Street or Rural Address where well is located: 701 LINCOLN ST., CONCORDIA

3 LOCATE WELL WITH 'X' IN SECTION BOX: N W E S 1 mile. 4 DEPTH OF COMPLETED WELL: 35 ft. 5 Latitude: 39.57042 Longitude: 97.65729 Elevation: 1373.67 ft.

7 WELL WATER TO BE USED AS: 1. Domestic: Household, Lawn & Garden, Livestock, Irrigation, Feedlot, Industrial. 2. Public Water Supply, Dewatering, Aquifer Recharge, Monitoring, Environmental Remediation, Oil Field Water Supply, Test Hole, Geothermal, Other.

Was a chemical/bacteriological sample submitted to KDHE? No. Water well disinfected? No.

8 TYPE OF CASING USED: PVC. CASING JOINTS: Threaded. TYPE OF SCREEN OR PERFORATION MATERIAL: PVC. SCREEN OR PERFORATION OPENINGS ARE: Mill Slot.


9 GROUT MATERIAL: Concrete Surface Completion 0-1. Nearest source of possible contamination: None.

Table with columns: FROM, TO, LITHOLOGIC LOG, FROM, TO, LITHO. LOG (cont.) or PLUGGING INTERVALS. Rows: 0 to .5 CONCRETE, .5 to 35 SILTY CLAY (CL).

11 CONTRACTOR'S OR LANDOWNER'S CERTIFICATION: This water well was constructed on 6/24/19 and this record is true to the best of my knowledge and belief.

Cloud

33-T5-R3W

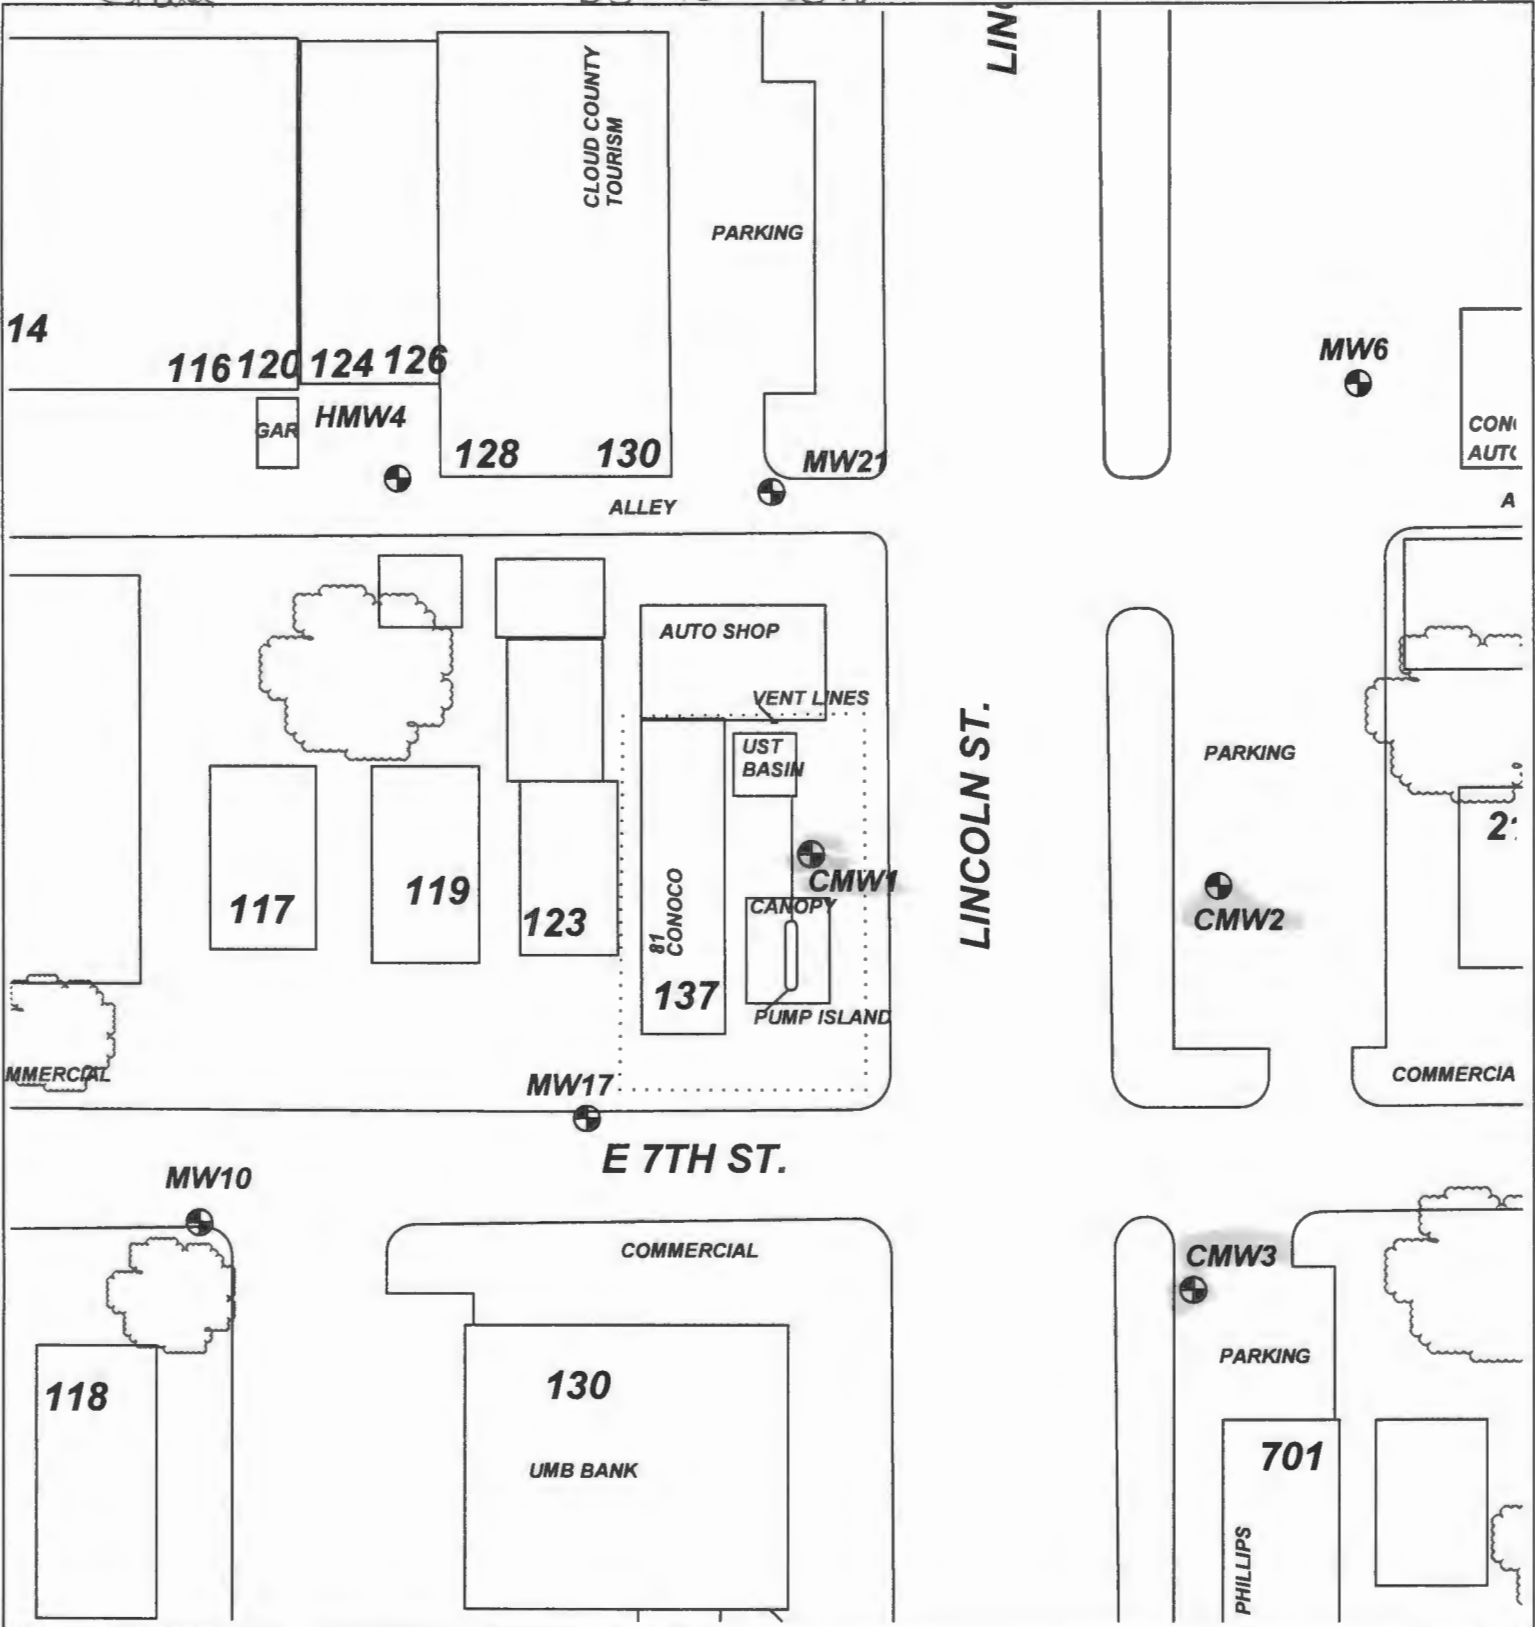

PROJECT: **81 CONOCO**

ADDRESS: **137 EAST 7TH**

LOCATION: **CONCORDIA, KS**

DRAWN BY: **B. JOHNSON** DATE: **7/13/18**

REVISED BY: **B. STALNAKER** DATE: **7/29/19**


AEI JOB #: **TM240** KQHE JOB #: **U5-015-15097**

TITLE:

ASSOCIATED ENVIRONMENTAL INC.

LEGEND:

- = UST Basin; 1-4,000 gal & 1-6,000 gal gasoline USTs
- = CONCORDIA CITY HALL/MURK AUTOMOTIVE U5-015-10390/U5-015-00219
- = HAIRSCOPE MONITORING WELL LOCATION
- = SUBJECT PROPERTY

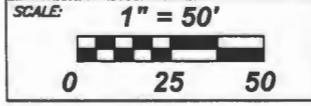

NOTES:
No basements observed within 500'.