
			WWC-5		vision of Water			MW7	
			ge in Well Use		ources App. No.		Well ID	\ \ \ \ \ \ \ \ \ \ \ \ \ \ \ \ \ \ \	
		VATER WELL:	Fraction		ction Number	Township Numb		nge Number	
County: Osborne NW 1/4 NW 1/4 SW 1/4 NW 1/4 17 T 7 S R 12 D E WELL OWNER: Last Name: Street or Rural Address where well is located (if unknown, distance and									
2 WELL OWNER: Last Name: First: Street or Rural Address where well is located (if unknown, distance and direction from nearest town or intersection): If at owner's address, check here:									
Address: 707 N 1st Street								check here:	
Address:			Street, Osbor	ne					
City: Osborne State: KS ZIP: 67473									
3 LOCAT		4 DEPTH OF CON	MPLETED WELL:	50 A	5 Latitud	39,4489	4	(decimal decrees)	
	Double(s) Consultant of Francisco (1)					t. 5 Latitude: 39.44894 (decimal degrees) Longitude: -98.69436 (decimal degrees)			
SECTION BOX: Depth(s) Groundwater Encountered: 1)						al Datum: WGS 84			
	15	WELL'S STATIC WA	TER LEVEL:	ft.	Source for	or Latitude/Longitude		65 LI NAD 27	
		☐ below land surface	below land surface, measured on (mo-day-yr)			(unit make/model:!	G8 Base/	Rover	
NW -	NE	☐ above land surface	above land surface, measured on (mo-day-yr)			(WAAS enabled? □			
		Pump test data: Well v	Pump test data: Well water was ft.			d Survey 🔲 Topogra	aphic Map		
W	E	after hour	after hours pumping gpm Well water was ft.			ne Mapper:			
SW	SE		after hours pumping gpm						
			Estimated Yield:gpm			n: 1466.04 ft.	Ground	d Level □ TOC	
	S	Bore Hole Diameter:	. ft and	Source: Land Survey GPS Topographic Map					
1	mile		in. to						
7 WELL WATER TO BE USED AS:									
1. Domestic	::	5. Public Wa	ater Supply: well ID		10. ☐ Oil F	ield Water Supply: le	ase		
100 mg/s =	☐ Household 6. ☐ Dewatering: how many wells?					11. Test Hole: well ID			
	□ Lawn & Garden 7. □ Aquifer Recharge: well ID □ Livestock 8. ■ Monitoring: well ID					☐ Cased ☐ Uncased ☐ Geotechnical			
	Livestock 8. Monitoring: well ID					12. Geothermal: how many bores?			
	2. Irrigation 9. Environmental Remediation: well ID					a) Closed Loop Horizontal Vertical			
	3. ☐ Feedlot ☐ Air Sparge ☐ Soil Vapor Extrac 4. ☐ Industrial ☐ Recovery ☐ Injection					b) Open Loop Surface Discharge Inj. of Water			
Test Commer (appears)).									
Was a chemical/bacteriological sample submitted to KDHE? ☐ Yes ■ No If yes, date sample was submitted:									
Water well disinfected? ☐ Yes ■ No									
8 TYPE OF CASING USED: ☐ Steel PVC ☐ Other CASING JOINTS: ☐ Glued ☐ Clamped ☐ Welded ■ Threaded									
Casing diameter									
Casing height above land surface in. Weight lbs./ft. Wall thickness or gauge No. Sch. 40									
TYPE OF SCREEN OR PERFORATION MATERIAL: Steel Stainless Steel Fiberglass PVC Other (Specify)									
☐ Steel ☐ Stainless Steel ☐ Fiberglass ☐ PVC ☐ Other (Specify) ☐ Brass ☐ Galvanized Steel ☐ Concrete tile ☐ None used (open hole)									
SCREEN OR PERFORATION OPENINGS ARE:									
☐ Continuous Slot									
Louvered Shutter									
SCREEN-PERFORATED INTERVALS: From .30									
GRAVEL PACK INTERVALS: From 28 ft. to 50 ft., From ft. to ft., From ft. to ft.									
9 GROUT MATERIAL: Neat cement Cement grout Bentonite Other Concrete									
GROUT MATERIAL: Neat cement Cement grout Bentonite Other Concrete Grout Intervals: From 6. ft. to 1. ft., From 1. ft. to 28. ft., From ft. to ft.									
Nearest source of possible contamination:									
Septic		☐ Lateral Line			Livestock Pens	☐ Insectic	ide Storage		
Sewer		Cess Pool	☐ Sewage Lag		Fuel Storage		ned Water V	Well	
□ Watertight Sewer Lines □ Seepage Pit □ Feedyard □ Fertilizer Storage □ Oil Well/Gas Well									
Other (Specify) Direction from well? Distance from well? ft.									
10 FROM	TO	LITHOLOG	CIC LOG	FROM	TO LI	THO. LOG (cont.) or	DILICON	CINTEDWALC	
0		Hydroexcavated - No		I KOW	TO LI	ino. Log (cont.) or	LUGGIN	JINIEKVALS	
5		Clay, Brown	Campio						
16		Clay, Lt. Brown to Yell	low Brown						
23		Clay, Yellow Brown	DIOWII						
32		Clay, Brown							
42		Sand, vf-c, Brown		1					
	-	Carra, VI O, DIOWII		Notes:					
	Trotes.								
11 CONTRACTOR'S OR LANDOWNER'S CERTIFICATION: This water well was constructed, reconstructed, or plugged									
under my j	urisdiction a	nd was completed on (m	no-day-year) .3/.18/20	20 and t	this record is to	ue to the best of my	knowledg	ge and belief.	
Kansas Water Well Contractor's License No. 527 This Water Well Record was completed on (more day-year) 3/19/2020									
under the business name of GeoCore, LLC. Signature									
Mail 1 white copy along with a fee of \$5.00 for each constructed well to: Kansas Department of Health and Environment, Bureau of Water, GWTS Section, 1000 SW Jackson St., Suite 420, Topeka, Kansas 66612-1367. Mail one to Water Well Owner and retain one for your records. Telephone 785-296-5524.									
Visit us at her	SW Jackson S	t., Suite 420, Topeka, Kansas (or your records. Telepho			
Visit us at http://www.kdheks.gov/waterwell/index.html KSA 82a-1212 Revised 7/10/2015									

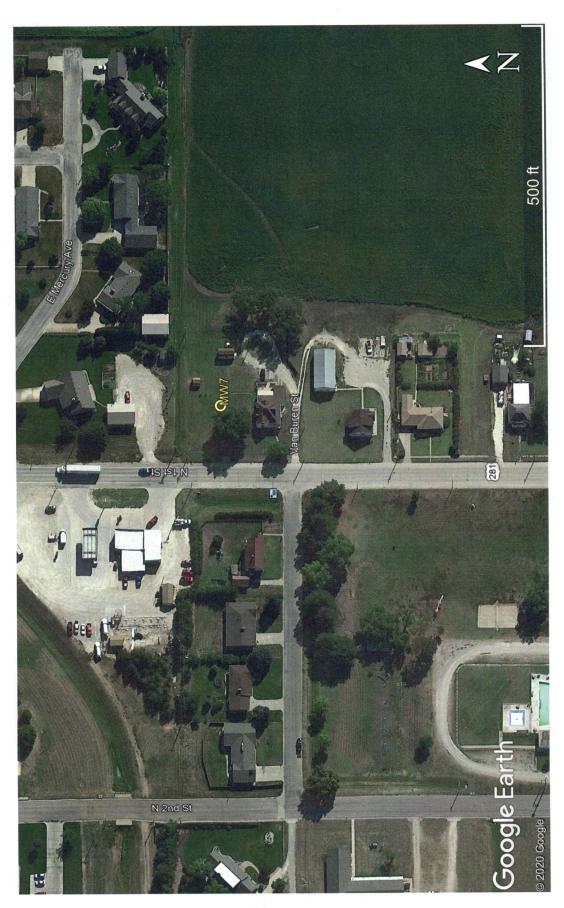

Project Site:

Midway Coop Assn, Osborne, Kansas KDHE Project Code: U6 071 11162

GPS Coordinates: Site: 39.44894, -98.69436

APR I 0 2020 BUREAU OF WATER