
			n WWC-5		Division of Water	1		AS15	
			ange in Well Use		esources App. No.		Well ID		
		WATER WELL:	Fraction		Section Number	Township Numbe		ge Number	
County: Rooks			SE 1/4 SW 1/4 NW 1/	SW 1/4	10	T 7 S	R 16	5 □ E ■ W	
2 WELL	OWNER:	Last Name:	First:	Street or F	or Rural Address where well is located (if unknown, distance and				
	s: J-J Oil			direction from nearest town or intersection): If at owner's address, check here:					
Address	:				wy 24 & Pine Street, Woodston				
Address	542	ooaston							
City:	Stockton	State: K	S ZIP: 67669						
3 LOCATE WELL 4 DEPTH OF COMPLETED WELL:					A   F T -444-3-	. 39.45619	1	/1- 1- 1 1 ×	
WITH "X" IN					11.   5 Latitude	00.000	′ 10	(decimal degrees)	
SECTION BOX: Depth(s) Groundwater Encountered: 13									
			3) ft., or 4) [				■ NAD	83 □ NAD 27	
			C WATER LEVEL: ft.		Source for	Source for Latitude/Longitude:			
'	'		□ below land surface, measured on (mo-day-yr)      □ above land surface, measured on (mo-day-yr)			☐ GPS (unit make/model: Spectra Precision)			
NW-	NE					WAAS enabled?		lo)	
			Pump test data: Well water was			☐ Land Survey ☐ Topographic Map			
					☐ Onlin	Online Mapper:			
X-swse			ll water was						
			after hours pumping gpm			6 Elevation: 1718.42ft. ■ Ground Level □ TOC			
j L		Estimated Yield:	imated Yield:gpm re Hole Diameter:8in. to56ft.			Source: Land Survey GPS Topographic Map			
							Other		
7 WELL WATER TO BE USED AS:									
1. Domestic	c:	5. 🔲 Public	Water Supply: well ID	• • • • • • • • • • • • • • • • • • • •	10. 🗖 Oil Fi	eld Water Supply: lea	se		
			ring: how many wells?				well ID		
☐ Lawn & Garden 7. ☐ Aquifer Re			Recharge: well ID		🔲 Cased	☐ Cased ☐ Uncased ☐ Geotechnical			
☐ Livest	tock		ring: well ID				•••••		
2. Irrigat	2. Irrigation 9. Environmental Remediation: well II					a) Closed Loop			
3. ☐ Feedlot ■ Air Sparge ☐ Soil Va									
4. Indus		☐ Recove							
Was a chemical/bacteriological sample submitted to KDHE?  Yes No If yes, date sample was submitted:									
Water well disinfected? ☐ Yes ■ No									
8 TYPE OF CASING USED: ☐ Steel ■ PVC ☐ Other									
Casing diameter									
Casing height above land surface									
TYPE OF SCREEN OR PERFORATION MATERIAL:									
☐ Steel ☐ Stainless Steel ☐ Fiberglass ■ PVC ☐ Other (Specify)									
☐ Brass ☐ Galvanized Steel ☐ Concrete tile ☐ None used (open hole)									
SCREEN OR PERFORATION OPENINGS ARE:									
☐ Continuous Slot									
□ Louvered Shutter □ Key Punched □ Wire Wrapped □ Saw Cut □ None (Open Hole)									
SCREEN-PERFORATED INTERVALS: From52 ft. to ft., From ft. to ft. ft. to ft.									
CDAVEL DACK INTERVALS. From 49 A to 56 A Francis II. III									
GRAVEL PACK INTERVALS: From									
9 GROUT MATERIAL: Neat cement Cement grout Bentonite Other									
Grout Intervals: From									
Nearest source of possible contamination:									
☐ Septic		☐ Lateral Li			Livestock Pens	☐ Insecticie	de Storage		
☐ Sewer		☐ Cess Pool		goon [	☐ Fuel Storage	☐ Abandon	ed Water V	Well	
☐ Watertight Sewer Lines ☐ Seepage Pit ☐ Feedyard ☐ Fertilizer Storage ☐ Oil Well/Gas Well									
Other (Specify)									
Direction from well?									
10 FROM	TO		OGIC LOG	FROM	TO LIT	HO. LOG (cont.) or F	LUGGING	INTERVALS	
0	5	Clay, Brown		1					
5		Clay, Light Brown to	Vellow Brown		<del>                    -     -</del>				
15		Silt, Very Light Brow							
23		Clay, Light Brown to	Yellow Brown						
30	36	Sand, vf-f							
36	56	Sand, vf-c w/f grave							
				Notes:				9,000	
	<del>                                     </del>			1					
11 CONTRACTORIS OR LANDOWNERS CORRESCATION TO 11									
11 CONTRACTOR'S OR LANDOWNER'S CERTIFICATION: This water well was constructed, reconstructed, or plugged									
under my jurisdiction and was completed on (mo-day-year) .1.1/9/2017 and this record is true to the best of my knowledge and belief.									
Kansas Water Well Contractor's License No. 527 This Water Well Record was completed on (mo-day-year) .11/21/2017									
under the business name of GeoCore Inc. Signature									
Mail 1 white copy along with a fee of \$5.00 for each constructed well to: Kansas Department of Health and Environment, Bureau of Water, GWTS Section,									
1000 SW Jackson St., Suite 420, Topeka, Kansas 66612-1367. Mail one to Water Well Owner and retain one for your records. Telephone 785-296-5524.									
Visit us at http://www.kdheks.gov/waterwell/index.html KSA 82a-1212 Revised 7/10/2015									

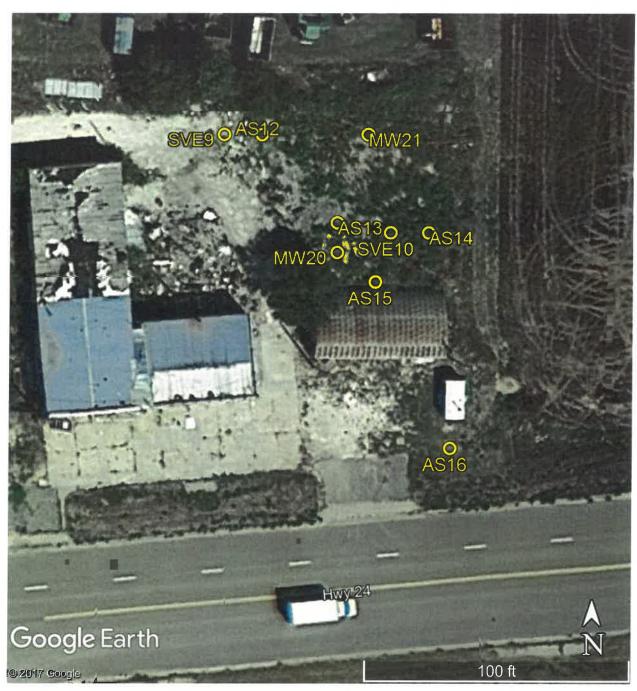

Don Osborne Site Hwy 24 & Pine Street, Woodston

## **GPS Coordinates:**

AS12: 39.45634, -99.09955 AS13: 39.45625, -99.09945 AS14: 39.45624, -99.09933 AS15: 39.45619, -99.09940 AS16: 39.45602, -99.09930 RECEIVED

DEC 0 6 2017

MW20: 39.45622, -99.09945 MW21: 39.45634, -99.09941

SVE9: 39.45634, -99.09960

SVE10: 39.45624, -99.09938