
			WWC-5		vision of Water			MW21	
			in Well Use Resources App.				Well ID		
1 LOCATION OF WATER WELL:			Fraction	1	ction Number	Township Numb		ige Number	
	y: Rooks		SE 1/4 SW 1/4 NW 1/4						
	OWNER:	Last Name:		Street or Rural Address where well is located (if unknown, distance and direction from nearest town or intersection): If at owner's address, check here:					
	J-J Oil			direction from	nearest town or in	tersection): If at owner	r's address, o	check here:	
Address: Address: PO Box 542 Hwy 24 & Pine Street, Woodston									
City:	Stockton		ZIP: 67669	,					
2 LOCATE WELL						20.4562	4		
4 DEPIH OF COMPLETED WELL:								(decimal degrees)	
			Encountered: 1)4			Longitude: -99.09941 (decimal degrees)			
			3) ft., or 4) ☐			Horizontal Datum: ☐ WGS 84 ■ NAD 83 ☐ NAD 27			
WELL'S STATIC W					Source for	Source for Latitude/Longitude: GPS (unit make/model:Spectra Precision)			
'			 □ below land surface, measured on (mo-day-yr) □ above land surface, measured on (mo-day-yr) 			(WAAS enabled? ☐ Yes ■ No)			
NW	NE		np test data: Well water was ft.			Land Survey Topographic Map			
			s pumping			Online Mapper:			
1 1	1 1 1	Well water was ft.							
SW	SE	after hours pumping gpm			(FI 4)	1718 63	-		
		Estimated Yield:		6 Elevation: 1718.63 ft. Ground Level TOC					
S		Bore Hole Diameter:		Source: Land Survey GPS Topographic Map					
1 mile in. to ft.									
7 WELL WATER TO BE USED AS:									
1. Domestic			ter Supply: well ID			10. Oil Field Water Supply: lease			
	☐ Household 6. ☐ Dewaterin		g: how many wells?			11. Test Hole: well ID			
Lawn & Garden 7. Aquifer Re			echarge: well IDg: well ID	/21	_	Cased Uncased Geotechnical			
			g: well ID	! .!		12. Geothermal: how many bores?			
						a) Closed Loop ☐ Horizontal ☐ Vertical b) Open Loop ☐ Surface Discharge ☐ Inj. of Water			
3. Feedle		☐ Air Sparge ☐ Recovery		xuaction					
Was a chemical/bacteriological sample submitted to KDHE? Yes No If yes, date sample was submitted:									
Water well disinfected? ☐ Yes ■ No									
8 TYPE OF CASING USED: ☐ Steel ■ PVC ☐ Other									
Casing diameter									
Casing height above land surface									
TYPE OF SCREEN OR PERFORATION MATERIAL:									
☐ Steel ☐ Stainless Steel ☐ Fiberglass ■ PVC ☐ Other (Specify)									
☐ Brass ☐ Galvanized Steel ☐ Concrete tile ☐ None used (open hole)									
SCREEN OR PERFORATION OPENINGS ARE: ☐ Continuous Slot									
☐ Continuous Slot ☐ Mill Slot ☐ Gauze Wrapped ☐ Torch Cut ☐ Drilled Holes ☐ Other (Specify)									
SCREEN-PERFORATED INTERVALS: From30 ft. to .55 ft., From ft. to ft.									
GRAVEL PACK INTERVALS: From									
9 GROUT MATERIAL: Neat cement Cement grout Bentonite Other Concrete									
Grout Intervals: From									
Nearest source of possible contamination:									
Septic Tank Lateral Lines Pit Privy Livestock Pens Insecticide Storage									
☐ Sewer Lines ☐ Cess Pool ☐ Sewage Lagoon ☐ Fuel Storage ☐ Abandoned Water Well									
☐ Watertight Sewer Lines ☐ Seepage Pit ☐ Feedyard ☐ Fertilizer Storage ☐ Oil Well/Gas Well									
Other (Specify)									
Direction from well? ft.									
10 FROM	TO	LITHOLOG		FROM	TO LI	THO. LOG (cont.) or	PLUGGING	G INTERVALS	
0		Clay, Brown to Dark B							
6		Clay, Very Light Brow	n to Yellow Brown						
18		Silt, Yellow Brown							
25		Clay, Yellow Brown							
31		Sand, vf-f							
37	48	Sand, vf-c w/f gravel							
				Notes:			7.11		
11 CONTRACTOR'S OR LANDOWNER'S CERTIFICATION: This water well was constructed, reconstructed, or plugged									
under my jurisdiction and was completed on (mo-day-year) .1.1/9/2017 and this record is true to the best of my knowledge and belief.									
Kansas Water Well Contractor's License No. 52/ This Water Well Record was completed on (mo-day-year) 1.1/21/2017									
under the business name of GeoCore Inc. Signature Signature Water GWTS Section									
Mail 1 white copy along with a fee of \$5.00 for each constructed well to: Kansas Department of Health and Environment, Bureau of Water, GWTS Section, 1000 SW Jackson St., Suite 420, Topeka, Kansas 66612-1367. Mail one to Water Well Owner and retain one for your records. Telephone 785-296-5524.									
1		-				or your records. Teleph			
visit us at http)://www.kdhek	s.gov/waterwell/index.html		KSA 82a-12	14		revised	7/10/2015	

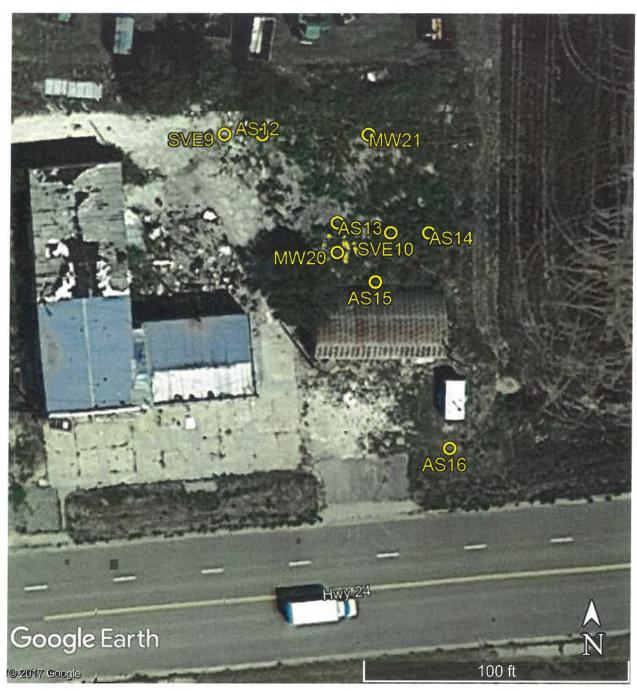

Don Osborne Site Hwy 24 & Pine Street, Woodston

GPS Coordinates:

AS12: 39.45634, -99.09955 AS13: 39.45625, -99.09945 AS14: 39.45624, -99.09933 AS15: 39.45619, -99.09940 AS16: 39.45602, -99.09930 RECEIVED

DEC 0 6 2017

MW20: 39.45622, -99.09945 MW21: 39.45634, -99.09941

SVE9: 39.45634, -99.09960

SVE10: 39.45624, -99.09938