
WATE	R WELL	RECORD		WWC-5		ivision of Wat	1]		SVE10		
Origin	al Record	☐ Correction		e in Well Use		sources App.		= 1: XY 1	Well ID	- N 1		
1 LOCA	TION OF	WATER WE	LL:	Fraction		ection Numb	er	Township Numb		ige Number		
Count	ty: Rooks			SE 1/4 SW 1/4 NW 1/		10		T 7 S		6 □ E ■ W		
2 WELL OWNER: Last Name: First: Street or Rural Address where well is located (if unknown, distance an												
								earest town or intersection): If at owner's address, check here:				
Address							ine Street, Woodston					
Audiess. FO BOX 542							•					
								20.4502				
	4 DEPIH OF COMPLETED WELL:							5 Latitude: 39.45624 (decimal degrees)				
	Deptin(s) Groundwater Encountered: 1)							-99.099				
N 2)								Datum: WGS 84		83 🗆 NAD 27		
WELL'S STATIC WATER LEVEL:												
below land surface, measured on (mo												
NW-			on (mo-day-yr)			(WAAS enabled? Yes No)						
		1	rater was				☐ Land Survey ☐ Topographic Map ☐ Online Mapper:					
W	1 1 1 I	anter	s pumpingvater was					• • • • • • • • • • • • • • • • • • • •				
X sw -	X SW SE after hours pumping											
Estimated Yield:			gnm	6 Elev	6 Elevation: 1718.39ft. Ground Level TOC							
S Bore Hole Diameter:			11 in to 45	Source	Source: Land Survey GPS Topographic Map							
j1	2010 11010	in. to	ft.		☐ Other							
7 WELL WATER TO BE USED AS:												
1. Domestic				ter Supply: well ID		10. □ 0	il Fiel	d Water Supply: le	ase			
	☐ Household 6. ☐ Dewatering: how many wells?											
	☐ Lawn & Garden 7. ☐ Aquifer Recharge: well ID											
	☐ Livestock 8. ☐ Monitoring: well ID											
2. 🔲 Irriga	2. ☐ Irrigation 9. Environmental Remediation: well ID .SVE.1						a) Closed Loop					
3. ☐ Feedlot ☐ Air Sparge ☐ Soil Vapor Ex 4. ☐ Industrial ☐ Recovery ☐ Injection												
4. Indus	trial		13. Other (specify):									
Was a chemical/bacteriological sample submitted to KDHE? Yes No If yes, date sample was submitted:												
Water well disinfected? ☐ Yes ■ No												
8 TYPE OF CASING USED: ☐ Steel ■ PVC ☐ Other CASING JOINTS: ☐ Glued ☐ Clamped ☐ Welded ■ Threaded												
Casing diameter 4 in to												
Casing diameter 4 in to 30 ft., Diameter in to ft., Diameter in to ft. Casing height above land surface 0 in Weight lbs./ft. Wall thickness or gauge No. Sch. 40												
TYPE OF SCREEN OR PERFORATION MATERIAL:												
☐ Steel ☐ Stainless Steel ☐ Fiberglass ☐ PVC ☐ Other (Specify)												
☐ Brass ☐ Galvanized Steel ☐ Concrete tile ☐ None used (open hole)												
SCREEN OR PERFORATION OPENINGS ARE:												
☐ Continuous Slot ☐ Mill Slot ☐ Gauze Wrapped ☐ Torch Cut ☐ Drilled Holes ☐ Other (Specify)												
□ Louvered Shutter □ Key Punched □ Wire Wrapped □ Saw Cut □ None (Open Hole)												
SCREEN-PERFORATED INTERVALS: From .30 ft. to .45 ft., From ft. to ft. ft. from ft. to ft.												
GRAVEL PACK INTERVALS: From28 ft. to45 ft., From ft. to ft. From ft. from ft. from ft. from ft. ft. ft.												
9 GROUT MATERIAL: Neat cement Cement grout Bentonite Other Grout Intervals: From												
Grout Intervals: From												
Nearest source of possible contamination:												
☐ Septic Tank ☐ Lateral Lines ☐ Pit Privy ☐ Livestock Pens ☐ Insecticide Storage												
Sewer			Cess Pool	☐ Sewage La		Fuel Storage		☐ Abando		Vell		
☐ Watertight Sewer Lines ☐ Seepage Pit ☐ Feedyard ☐ Fertilizer Storage ☐ Oil Well/Gas Well												
☐ Other (Specify)												
10 FROM	TO	T	ITHOLOG	IC LOC	FROM	ТО			DI LICORY	Difference		
0	5	Clay, Brown		IC DOG	TROM	10	LIIH	O. LOG (cont.) or	LLUGGIN(JINIEKVALS		
5	15	Clay, Light B			+							
15	24				 					*		
		Clay, Very L										
24	30		prown to	Very Light Brown								
30	35	Sand, vf-m										
35	45	Sand, vf-c w	/t gravel									
L					Notes:							
11 CONTRACTORIS OR VANDOUS PROPERTY OF THE PRO												
11 CONTRACTOR'S OR LANDOWNER'S CERTIFICATION: This water well was constructed, reconstructed, or plugged												
under my jurisdiction and was completed on (mo-day-year) .1.1/9/2017 and this record is true to the best of my knowledge and belief. Kansas Water Well Contractor's License No. 527 This Water Well Record was completed of (mo-day-year) .1.1/2/1/2017												
Nansas Wa	ter well Co	nuractor's Lice	nse No?	41 This Wa	ter Well Re	cord was con	nplete	d on (mo-day-ye	1.1/21/	2017		
Mail	white conve	long with a fee of	\$.00 for each	constructed well to: Von	Si	gnature	!	well fler	7			
Mail 1 white copy along with a fee of \$5.00 for each constructed well to: Kansas Department of Health and Environment, Bureau of Water, GWTS Section, 1000 SW Jackson St., Suite 420, Topeka, Kansas 66612-1367. Mail one to Water Well Owner and retain one for your records. Telephone 785-296-5524.												
Visit us at http	·//www.kdhat	si., Suite 420, 10p is.gov/waterwell/ii	eka, Maiisas O ndev html		Water Well Ow KSA 82a-12		ne for y	our records. Telepho				
, son us at ntt	W. M. H. W. AUHCE	w. gov matel well/il	INVA.IIIIII		1701 079-17	14			Kevised	7/10/2015		

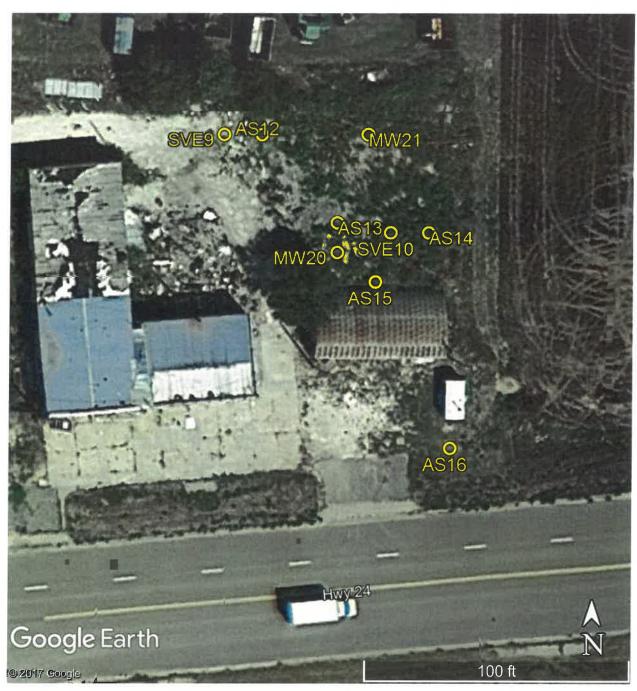

Don Osborne Site Hwy 24 & Pine Street, Woodston

GPS Coordinates:

AS12: 39.45634, -99.09955 AS13: 39.45625, -99.09945 AS14: 39.45624, -99.09933 AS15: 39.45619, -99.09940 AS16: 39.45602, -99.09930 RECEIVED

DEC 0 6 2017

MW20: 39.45622, -99.09945 MW21: 39.45634, -99.09941

SVE9: 39.45634, -99.09960

SVE10: 39.45624, -99.09938