
KOLAR Document ID: 1581051

				WWC-5		vision of Wat			Wall ID			
	I Record			e in Well Use Fraction		ources App.	1	Township Numb	Well ID	ao Numbor		
County		AIEK WEI	ıL;			cuon numb	er	T S	R R	ge Number $\Box \to \Box W$		
	OWNER: La	st Name:				ral Address	whe	re well is located				
Business:	O WILLA	st manne.										
Address:					uncetion nom	rection from nearest town or intersection): If at owner's address, check here:						
Address:			_									
City:			State:	ZIP:								
3 LOCAT		4 DEPTH	OF COM	IPLETED WELL: .	fi	t. 5 Latit	tude:			(decimal degrees)		
WITH " SECTIO		Depth(s) Gr	oundwater	Encountered: 1)	ft.		Longitude:(decimal degrees) Datum: WGS 84 NAD 83 NAD 27					
SECTIO N				3) ft., or 4)								
			TER LEVEL:			Source for Latitude/Longitude:						
	1			yr)								
NW	NE		, measured on (mo-day- vater was ft		(WAAS enabled? Yes No)							
w	E		hours			□ Land Survey □ Topographic Map □ Online Mapper:						
		untertit	Well w									
SW	SE	after	s pumping									
		Estimated Y			6 Elevation:ft. Ground Level T							
-	S	Bore Hole I			Source: Land Survey GPS Topographic M Other							
1 n				in. to	ft.				•••••			
	WATER TO			ten Constant II ID			1 E.	1 J W - 4 - 1 C 1 1				
	. Domestic: 5. □ Public Water Supply: well ID □ Household 6. □ Dewatering: how many wells?							ld Water Supply: le				
\square House				echarge: well ID								
			· •	g: well ID				al: how many bores				
2. 🗌 Irrigati				al Remediation: well ID				Loop Horizont				
3. 🗌 Feedlo] Air Sparge	e 🛛 🗌 Soil Vapor E	Extraction							
4. 🗌 Industr	ial		Recovery	Injection		13. 🗌 Other (specify):						
Was a cher	nical/bacter	iological sar	nple subm	nitted to KDHE? 🔲	Yes 🗌 No	If yes, dat	te san	nple was submitted	d:			
Water well	disinfected?	☐ Yes □	No			•		•				
8 TYPE O	F CASING	USED: 🗆 S	teel 🗌 PV	C 🗌 Other	CASI	NG JOINT:	S: □	Glued Clamped	Welded	1 🗌 Threaded		
				Diameter								
				n. Weight	lbs./ft.	Wall thic	kness	or gauge No				
	SCREEN OR		FION MA			— -						
□ Steel		less Steel			17 1 1		ther (S	Specify)	•••••			
Brass		anized Steel	NINCS AI		sed (open hol	e)						
		☐ Mill Slot			rch Cut 🗖 I	Trilled Holes		Other (Specify)				
		Key Puncl				None (Open 1		Other (Speerry)	• • • • • • • • • • • • • • • • • • • •			
				n ft. to				ft., From	ft. to	ft.		
				n ft. to	,			,				
] Cement grout 🛛 Be								
				ft., From								
	rce of possible			potential source of cont								
Septic 7			Lateral Line			Livestock P			ide Storage			
Sewer I			Cess Pool		goon 🗌	Fuel Storage			oned Water	Well		
				Feedyard		Fertilizer St	orage		ll/Gas Well			
				Distance from we				ft				
10 FROM	TO		ITHOLOG		FROM	ТО		HO. LOG (cont.) or	PLUGGIN	G INTERVALS		
					Notes:							
					_							
44 6 6 5 1 -		<u> </u>				17	_					
11 CONT	11 CONTRACTOR'S OR LANDOWNER'S CERTIFICATION: This water well was constructed, reconstructed, or plugged											
under my jurisdiction and was completed on (mo-day-year) and this record is true to the best of my knowledge and belief. Kansas Water Well Contractor's License No												
under the h	under the business name of											
	S	end one copy to	WATER W	ELL OWNER and retain o	one for your rec	ords. Fee of \$	5.00 f	or each constructed we	11.			
KS Departn	nent of Health ar	nd Environment	, Bureau of V	Water, Geology Section, 10	00 SW Jackson	St., Suite 420	, Tope	ka, Kansas 66612-136	Telephone	e 785-296-3565.		
Visit us at h	ttp://www.kdhek	s.gov/waterwel	l/index.html						KS	SA 82a-1212		

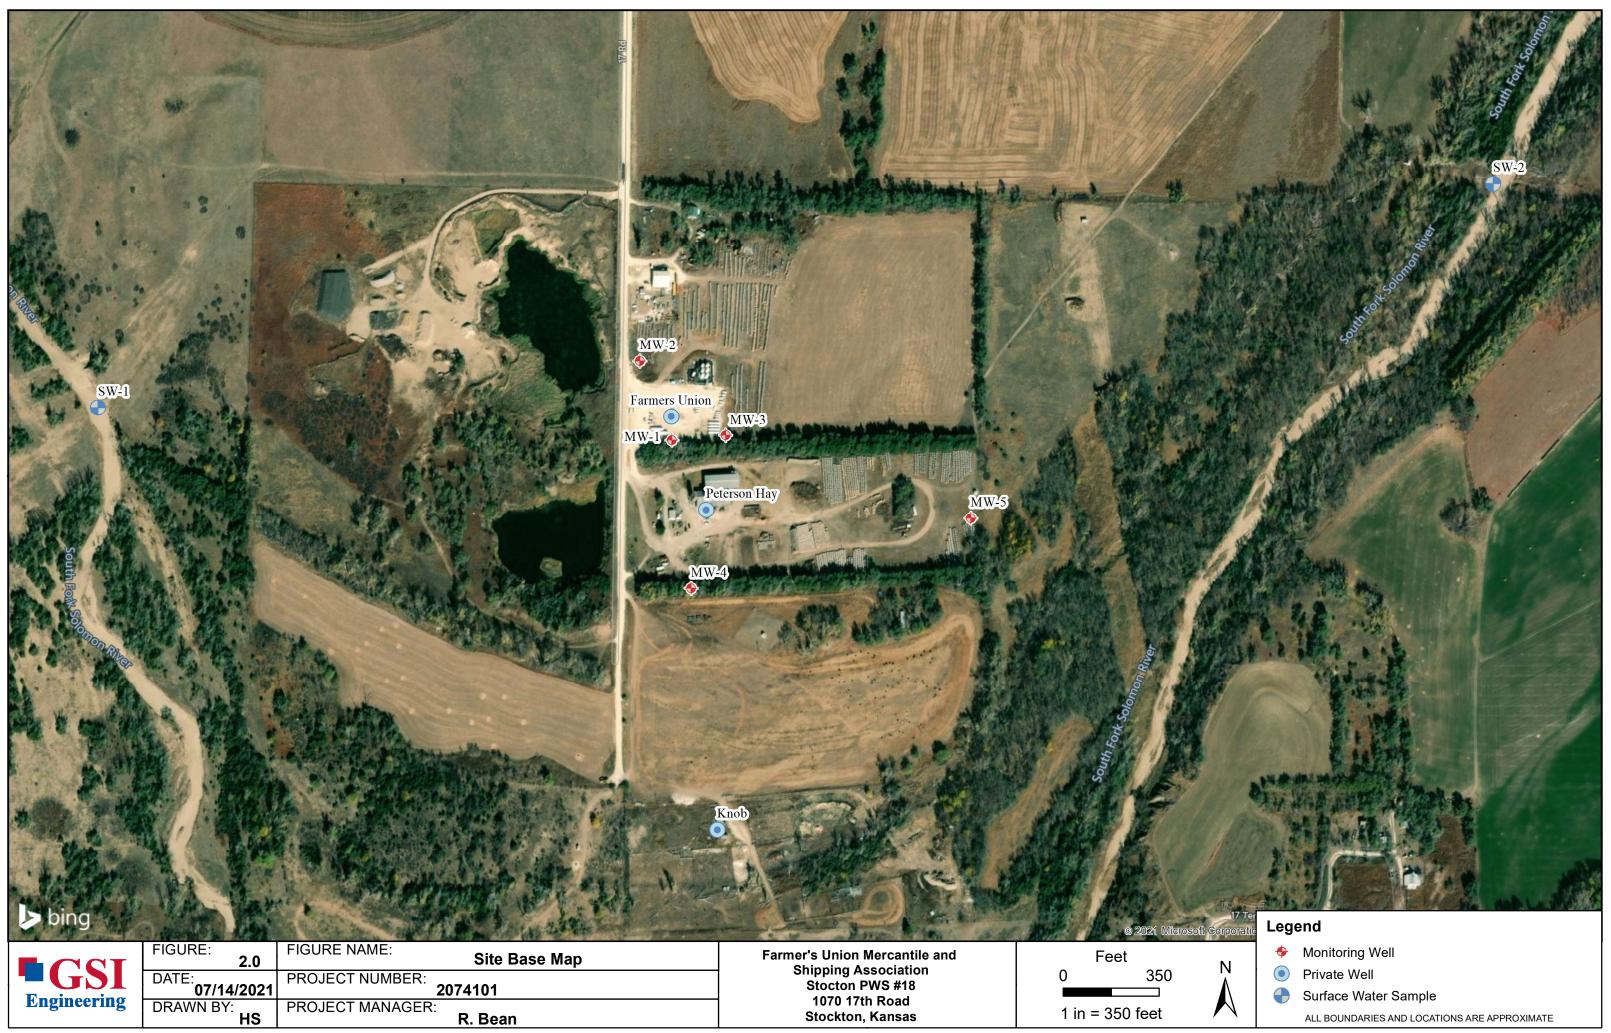

Stockton, Kansas

R. Bean

1	in	=	35	Ô	fee
		_	00	v	

ALL BOUNDARIES AND LOCATIONS ARE APPROXIMATE