
KOLAR Document ID: 1489468

	WELL R			WWC-5		vision of Wate						
Original Record Correction Change in Well				Resources App. No.			T 1' M 1	Well ID				
1 LOCATION OF WATER WELL: Fraction				-				ige Number				
County: 1/4 1/4 1/4 2 WELL OWNER: Last Name: First: S						$\begin{array}{ c c c c c c } T & S & R & \Box E & \Box W \\ \hline r & Rural Address where well is located (if unknown, distance and \\ \hline \end{array}$						
2 WELL Business:		ast Name:		First:						,		
Address:					direction nom	irection from nearest town or intersection): If at owner's address, check here:						
Address:												
City:		1	State:	ZIP:								
3 LOCAT		4 DEPTH	OF CON	IPLETED WELL: .	fi	5 Latit	nqe.			(decimal degrees)		
WITH "	X'' IN DN BOX:			Encountered: 1)		5 Latitude:(decimal degrees) Longitude:(decimal degrees)						
SECIIC		2)	ft. 🤅	3) ft., or 4)	Dry Well		Datum: WGS 84 NAD 83 NAD 27					
				TER LEVEL:				atitude/Longitude				
				, measured on (mo-day- , measured on (mo-day-								
NW	NE			vater was f		\Box Land Survey \Box Topographic Map			10)			
w	E			s pumping								
			Well w	vater was f	t.							
	SE			s pumping	gpm	6 Flove	tion.	A				
<u> </u>		Estimated Y			6 Elevation: ft and ft and Source: Land Survey GPS							
1 r	S nilel	Bore Hole I		in. to in. to	Source		Other					
	WATER TO	BE USED /		······ III. 10 ······	II.		<u> </u>					
1. Domestic:				ter Supply: well ID		10. 🗆 O	il Field	Water Supply: 16	ease			
House				ig: how many wells?				well ID				
Lawn d		7. 🗖	Aquifer R	echarge: well ID			ased	Uncased	Geotechnica	1		
□ Liveste				g: well ID				: how many bores				
2. 🗌 Irrigati				al Remediation: well II				Loop 🗌 Horizon				
3. ☐ Feedlo 4. ☐ Industr] Air Sparge] Recovery		Extraction	b) Open Loop □ Surface Discharge □ Inj. of Water 13. □ Other (specify):						
			-				• •					
				nitted to KDHE?	Yes 🗌 No	If yes, date	e samp	ple was submitte	:d:	•••••		
	disinfected?			C 🗆 Other	CASI	NC IONTS			1 🗖 Walda	d 🗖 Thursdad		
				Diameter								
	ht above land s							or gauge No				
	SCREEN OR							0				
□ Steel		less Steel		D PVC		🗌 Otl	her (Sp	ecify)				
□ Brass		anized Steel			ised (open hole	e)						
	OR PERFOR											
	nuous Slot	☐ Mill Slot						ther (Specify)				
	ered Shutter	□ Key Puncl		\square Sa		None (Open H		ft From	ft to	Ĥ		
				n ft. to								
				Cement grout \Box Be								
				ft., From						••••		
	rce of possible	e contaminati	on: No	potential source of con	tamination wi	thin 200 ft.						
			Lateral Line			Livestock Pe	ens		cide Storage			
Sewer			Cess Pool		goon 🗌	Fuel Storage	e		oned Water			
	ight Sewer Lin (Specify)	ies 🗆 S		☐ Feedyard		Fertilizer Sto	orage		ll/Gas Well			
				Distance from w				Ĥ				
10 FROM	ТО		ITHOLO		FROM	ТО		O. LOG (cont.) of		G INTERVALS		
					-							
					Notore							
					Notes:							
					-							
11 CONTRACTOR'S OR LANDOWNER'S CERTIFICATION: This water well was constructed, reconstructed, or plugged												
under my jurisdiction and was completed on (mo-day-year) and this record is true to the best of my knowledge and belief.												
Kansas Wa	ter Well Con	tractor's Lice	ense No	This Wa	ater Well Red	cord was con	mplete	ed on (mo-day-y	ear)	-		
under the b	usiness name	e of	WATED W	ELL OWNER and retain	one for vour re-	orde Eccafe	5 00 for	and constructed		<u></u>		
KS Departr				Vater, Geology Section, 10						e 785-296-3565.		
	ttp://www.kdhe									SA 82a-1212		

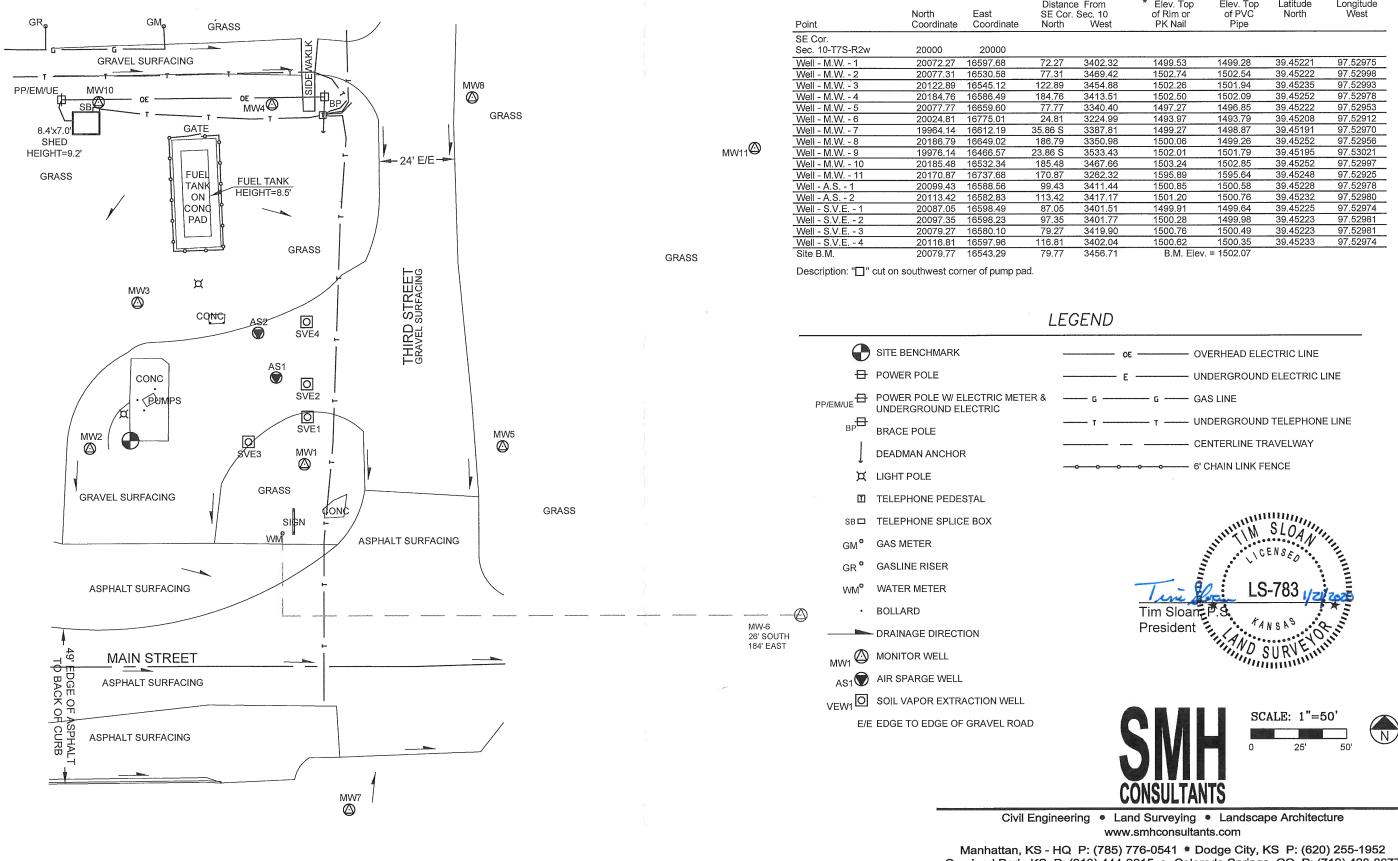

⊘ MW9

Manhattan, KS - HQ P: (785) 776-0541 • Dodge City, KS P: (620) 255-1952 Overland Park, KS P: (913) 444-9615 • Colorado Springs, CO P: (719) 428-8677 Drawn By:DBA Project #1912MN1375 DD #117 TDS #79

JAN 29 2020


1987Le


FULL SITE SURVEY

City of Aurora

City of Aurora, Cloud County, Kansas

Distance From SE Cor. Sec. 10 North West		* Elev. Top Elev. Top of Rim or of PVC PK Nail Pipe		Latitude North	Longitude West
72.27	3402.32	1499.53	1499.28	39.45221	97.52975
77.31	3469.42	1502.74	1502.54	39.45222	97.52998
122.89	3454.88	1502.26	1501.94	39.45235	97.52993
184.76	3413.51	1502.50	1502.09	39.45252	97.52978
77.77	3340.40	1497.27	1496.85	39.45222	97.52953
24.81	3224.99	1493.97	1493.79	39.45208	97.52912
35.86 S	3387.81	1499.27	1498.87	39.45191	97.52970
186.79	3350.98	1500.06	1499.26	39.45252	97.52956
23.86 S	3533.43	1502.01	1501.79	39.45195	97.53021
185.48	3467.66	1503.24	1502.85	39.45252	97.52997
170.87	3262.32	1595.89	1595.64	39.45248	97.52925
99.43	3411.44	1500.85	1500.58	39.45228	97.52978
113.42	3417.17	1501.20	1500.76	39.45232	97.52980
87.05	3401.51	1499.91	1499.64	39.45225	97.52974
97.35	3401.77	1500.28	1499.98	39.45223	97.52981
79.27	3419.90	1500.76	1500.49	39.45223	97.52981
116.81	3402.04	1500.62	1500.35	39.45233	97.52974
79.77	3456.71	B.M. Elev.	= 1502.07		

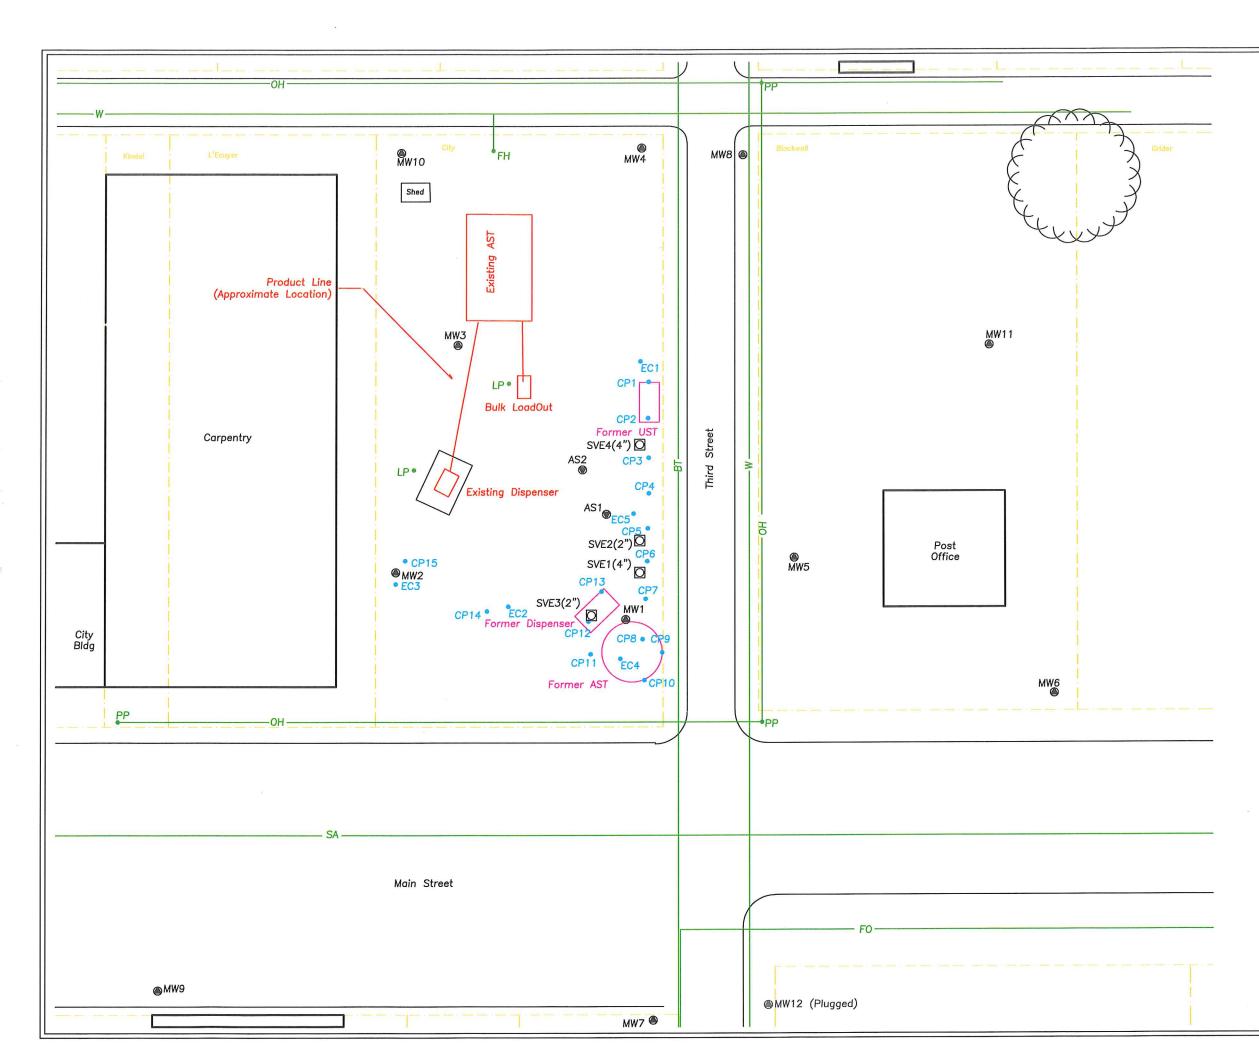

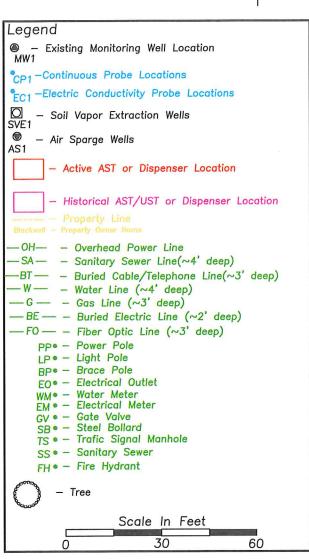

N

Site Detail Map
City of Aurora
City of Aurora Aurora, Kansas KDHE Project: U5–015–13668
Remedial Design Report
CGP Project #19876K
Prepared By: MK Date: 12-24-2019
Reviewed By: MK Date: 12-24-2019
Figure 1.4
CGP, Inc. PO Box 23, Wahoo, NE 68066