

WATER WELL RECORD Form WWC-5

Original Record Correction Change in Well Use


Division of Water Resources App. No.

Well ID MW-8s

1 LOCATION OF WATER WELL: County: Cloud Fraction NE 1/4 SE 1/4 NE 1/4 NE 1/4 Section Number 20 Township Number T 8 S Range Number R 01 E W

2 WELL OWNER: Last Name: First: Street or Rural Address where well is located (if unknown, distance and direction from nearest town or intersection): If at owner's address, check here: East end of Farmway Coop facility in Miltonvale, KS Business: Farmway Coop Address: 204 E. Court St. PO Box 568 City: Beloit State: Kansas ZIP: 67420

3 LOCATE WELL WITH "X" IN SECTION BOX: N

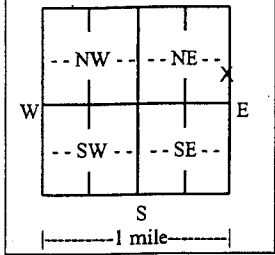

4 DEPTH OF COMPLETED WELL: 25 ft. Depth(s) Groundwater Encountered: 1) 12 ft. 2) ft. 3) ft., or 4) Dry Well WELL'S STATIC WATER LEVEL: 12.43 ft. below land surface, measured on (mo-day-yr): 9-7-16. above land surface, measured on (mo-day-yr) Pump test data: Well water was ft. after hours pumping gpm Well water was ft. after hours pumping gpm Estimated Yield: gpm Bore Hole Diameter: 8.5 in. to 25 ft. and in. to ft.

5 Latitude: 39.34752 (decimal degrees) Longitude: 97.44460 (decimal degrees) Horizontal Datum: WGS 84 NAD 83 NAD 27 Source for Latitude/Longitude: GPS (unit make/model: (WAAS enabled? Yes No) Land Survey Topographic Map Online Mapper:

6 Elevation: 1374.14 ft. Ground Level TOC Source: Land Survey GPS Topographic Map Other

7 WELL WATER TO BE USED AS: 1. Domestic: Household Lawn & Garden Livestock 2. Irrigation 3. Feedlot 4. Industrial 5. Public Water Supply: well ID 6. Dewatering: how many wells? 7. Aquifer Recharge: well ID 8. Monitoring: well ID MW-8s 9. Environmental Remediation: well ID Air Sparge Soil Vapor Extraction Recovery Injection 10. Oil Field Water Supply: lease 11. Test Hole: well ID Cased Uncased Geotechnical 12. Geothermal: how many bores? a) Closed Loop Horizontal Vertical b) Open Loop Surface Discharge Inj. of Water 13. Other (specify):

Was a chemical/bacteriological sample submitted to KDHE? Yes No If yes, date sample was submitted: Water well disinfected? Yes No

8 TYPE OF CASING USED: Steel PVC Other CASING JOINTS: Glued Clamped Welded Threaded Casing diameter 2 in. to 15 ft., Diameter in. to ft., Diameter in. to ft. Casing height above land surface 24 in. Weight lbs./ft. Wall thickness or gauge No. Sch. 40


TYPE OF SCREEN OR PERFORATION MATERIAL: Steel Stainless Steel Fiberglass PVC Other (Specify) Brass Galvanized Steel Concrete tile None used (open hole) SCREEN OR PERFORATION OPENINGS ARE: Continuous Slot Mill Slot Gauze Wrapped Torch Cut Drilled Holes Other (Specify) Louvered Shutter Key Punched Wire Wrapped Saw Cut None (Open Hole) SCREEN-PERFORATED INTERVALS: From 15 ft. to 25 ft., From ft. to ft., From ft. to ft. GRAVEL PACK INTERVALS: From 13 ft. to 25 ft., From ft. to ft., From ft. to ft.

9 GROUT MATERIAL: Neat cement Cement grout Bentonite Other Grout Intervals: From 1 ft. to 13 ft., From ft. to ft., From ft. to ft. Nearest source of possible contamination: Septic Tank Lateral Lines Pit Privy Livestock Pens Insecticide Storage Sewer Lines Cess Pool Sewage Lagoon Fuel Storage Abandoned Water Well Watertight Sewer Lines Seepage Pit Feedyard Fertilizer Storage Oil Well/Gas Well Other (Specify) Nitrate impacted Voluntary Clean up site Direction from well? On-site Distance from well? 0 ft.

Table with columns: FROM, TO, LITHOLOGIC LOG, FROM, TO, LITHO. LOG (cont.) or PLUGGING INTERVALS. Row 1: 0, 25, Silty Clay, bn to lt. bn sat. @-12ft, , , , , . Row 2: 25, TD, , , , , .

Notes: Above Grade completion

11 CONTRACTOR'S OR LANDOWNER'S CERTIFICATION: This water well was constructed, reconstructed, or plugged under my jurisdiction and was completed on (mo-day-year) 8/9/2016 and this record is true to the best of my knowledge and belief. Kansas Water Well Contractor's License No. 585 This Water Well Record was completed on (mo-day-year) 11/1/2016 under the business name of Associated Environmental, Inc. Signature

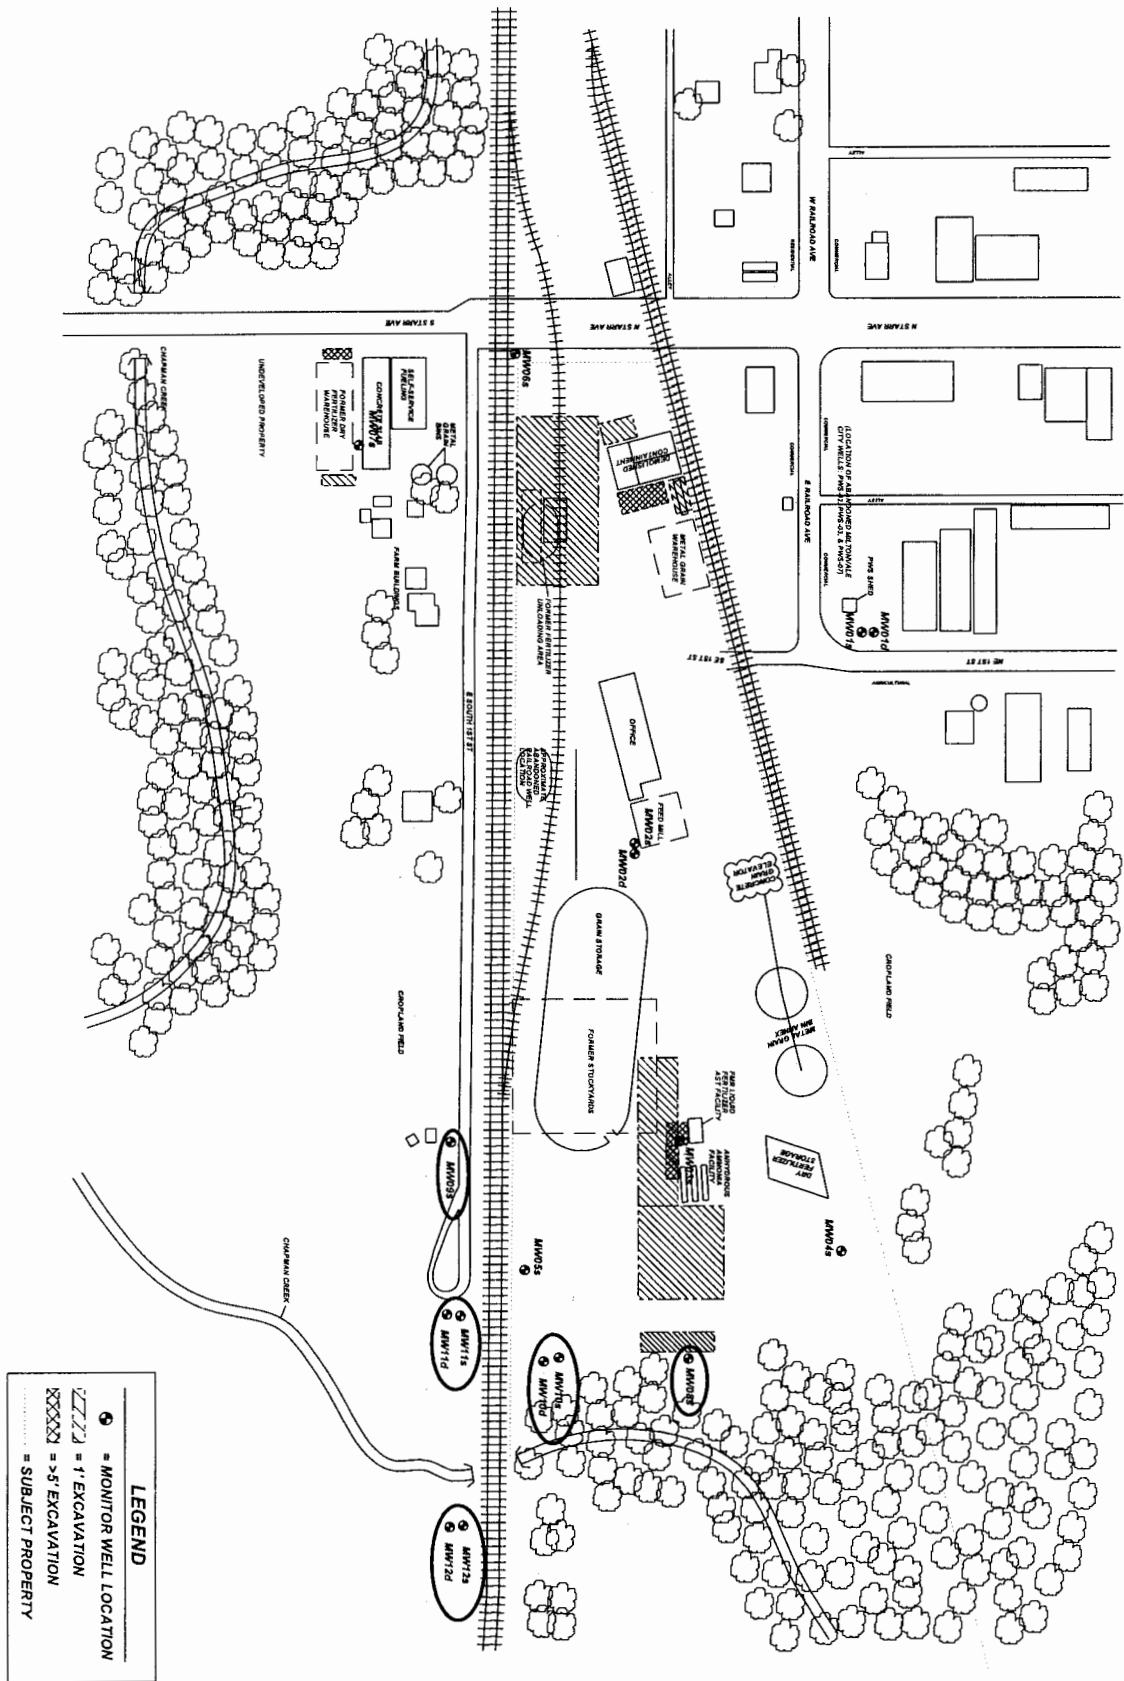

SCALE: 1" = 150'	NOTES: Sample Date: 9/7/2016	TITLE: Figure 1 Site Map		ASSOCIATED ENVIRONMENTAL INC.	
0 75 150					
PROJECT: FARMWAY COOP MILTONVALE FACILITY	ADDRESS: SE 1ST ST	LOCATION: Miltonvale, KS	DRAWN BY: B. Scott	DATE: 11/22/16	REVISED BY: B. Johnson 11/22/16
					KDHE JOB #: #01VCP009
					AEI JOB #: VC018