

WATER WELL RECORD Form WWC-5

Division of Water Resources App. No.

MW-5

Original Record Correction Change in Well Use

Well ID

1 LOCATION OF WATER WELL: County: Sherman Fraction NE 1/4 NE 1/4 SE 1/4 SE 1/4 Section Number 25 Township Number T 8 S Range Number R 40 E W

2 WELL OWNER: Last Name: Business: Triplett, Inc Address: PO Box 647 City: Salina State: KS ZIP: 67402 Street or Rural Address where well is located: 2710 Commerce Road, Goodland

3 LOCATE WELL WITH "X" IN SECTION BOX: N W E S

4 DEPTH OF COMPLETED WELL: 230.4 ft. Depth(s) Groundwater Encountered: 1) 2) 3) 4) Dry Well WELL'S STATIC WATER LEVEL: 212.50 ft. below land surface, measured on (mo-day-yr) 3/8/2023. Pump test data: Well water was after hours pumping gpm Well water was after hours pumping gpm Estimated Yield: gpm Bore Hole Diameter: 8.5 in. to 230.4 ft. and in. to ft.

5 Latitude: 39.325692 (decimal degrees) Longitude: 101.726677 (decimal degrees) Horizontal Datum: WGS 84 NAD 83 NAD 27 Source for Latitude/Longitude: GPS (unit make/model: SPECTRA/SP85) (WAAS enabled? Yes No) Land Survey Topographic Map Online Mapper: Elevation: 3706.82 ft. Ground Level TOC Source: Land Survey GPS Topographic Map Other

7 WELL WATER TO BE USED AS: 1. Domestic: Household Lawn & Garden Livestock Irrigation Feedlot Industrial 2. Public Water Supply: well ID Dewatering: how many wells? Aquifer Recharge: well ID Monitoring: well ID MW-5 Environmental Remediation: well ID Air Sparge Soil Vapor Extraction Recovery Injection Oil Field Water Supply: lease Test Hole: well ID Cased Uncased Geotechnical Geothermal: how many bores? a) Closed Loop Horizontal Vertical b) Open Loop Surface Discharge Inj. of Water Other (specify):

Was a chemical/bacteriological sample submitted to KDHE? Yes No If yes, date sample was submitted: Water well disinfected? Yes No

8 TYPE OF CASING USED: Steel PVC Other CASING JOINTS: Glued Clamped Welded Threaded Casing diameter 4 in. to 230.4 ft., Diameter in. to ft., Diameter in. to ft. Casing height above land surface -4 in. Weight lbs./ft. Wall thickness or gauge No. TYPE OF SCREEN OR PERFORATION MATERIAL: Steel Stainless Steel Fiberglass PVC Other (Specify) Brass Galvanized Steel Concrete tile None used (open hole) SCREEN OR PERFORATION OPENINGS ARE: Continuous Slot Mill Slot Gauze Wrapped Torch Cut Drilled Holes Other (Specify) Louvered Shutter Key Punched Wire Wrapped Saw Cut None (Open Hole) SCREEN-PERFORATED INTERVALS: From 200 ft. to 230.4 ft., From ft. to ft., From ft. to ft. GRAVEL PACK INTERVALS: From 198 ft. to 230.4 ft., From ft. to ft., From ft. to ft.

9 GROUT MATERIAL: Neat cement Cement grout Bentonite Other Grout Intervals: From 1 ft. to 198 ft., From ft. to ft., From ft. to ft. Nearest source of possible contamination: Septic Tank Lateral Lines Pit Privy Livestock Pens Insecticide Storage Sewer Lines Cess Pool Sewage Lagoon Fuel Storage Abandoned Water Well Watertight Sewer Lines Seepage Pit Feedyard Fertilizer Storage Oil Well/Gas Well Other (Specify) Direction from well? Distance from well? ft.

Table with 6 columns: 10 FROM, TO, LITHOLOGIC LOG, FROM, TO, LITHO. LOG (cont.) or PLUGGING INTERVALS. Rows include: 0-0.5 Asphalt, 0.5-10 Clay with silt, 10-31 Silt, 31-56 Clay and caliche, 56-73 Gravelly sand with clay, 73-76 Caliche with gravelly sand, 76-119 Gravelly sand, 119-153 Clay and caliche with sand, 153-180 Gravelly sand with clay. Notes: Goodland 24-7 Travel Store KDHE Project Code: U6-091-15432


11 CONTRACTOR'S OR LANDOWNER'S CERTIFICATION: This water well was constructed, reconstructed, or plugged under my jurisdiction and was completed on (mo-day-year) 2/20/2023 and this record is true to the best of my knowledge and belief. Kansas Water Well Contractor's License No. 881. This Water Well Record was completed on (mo-day-year) 3/28/2023 under the business name of Woofter Pump & Well Signature

Twp. 8 Rge. 40W Sec. 25

County: Sherman

KDHE: Goodland 24-7 Travel Store, U6-091-15432

PLotted: 3/29/2023 10:58 AM SAVED: 3/30/2023 10:44 AM Brian S. Fahrbrunh g:\Projects\251\251-FV24-03\LSA_3-2023\Figure 2.2.dwg

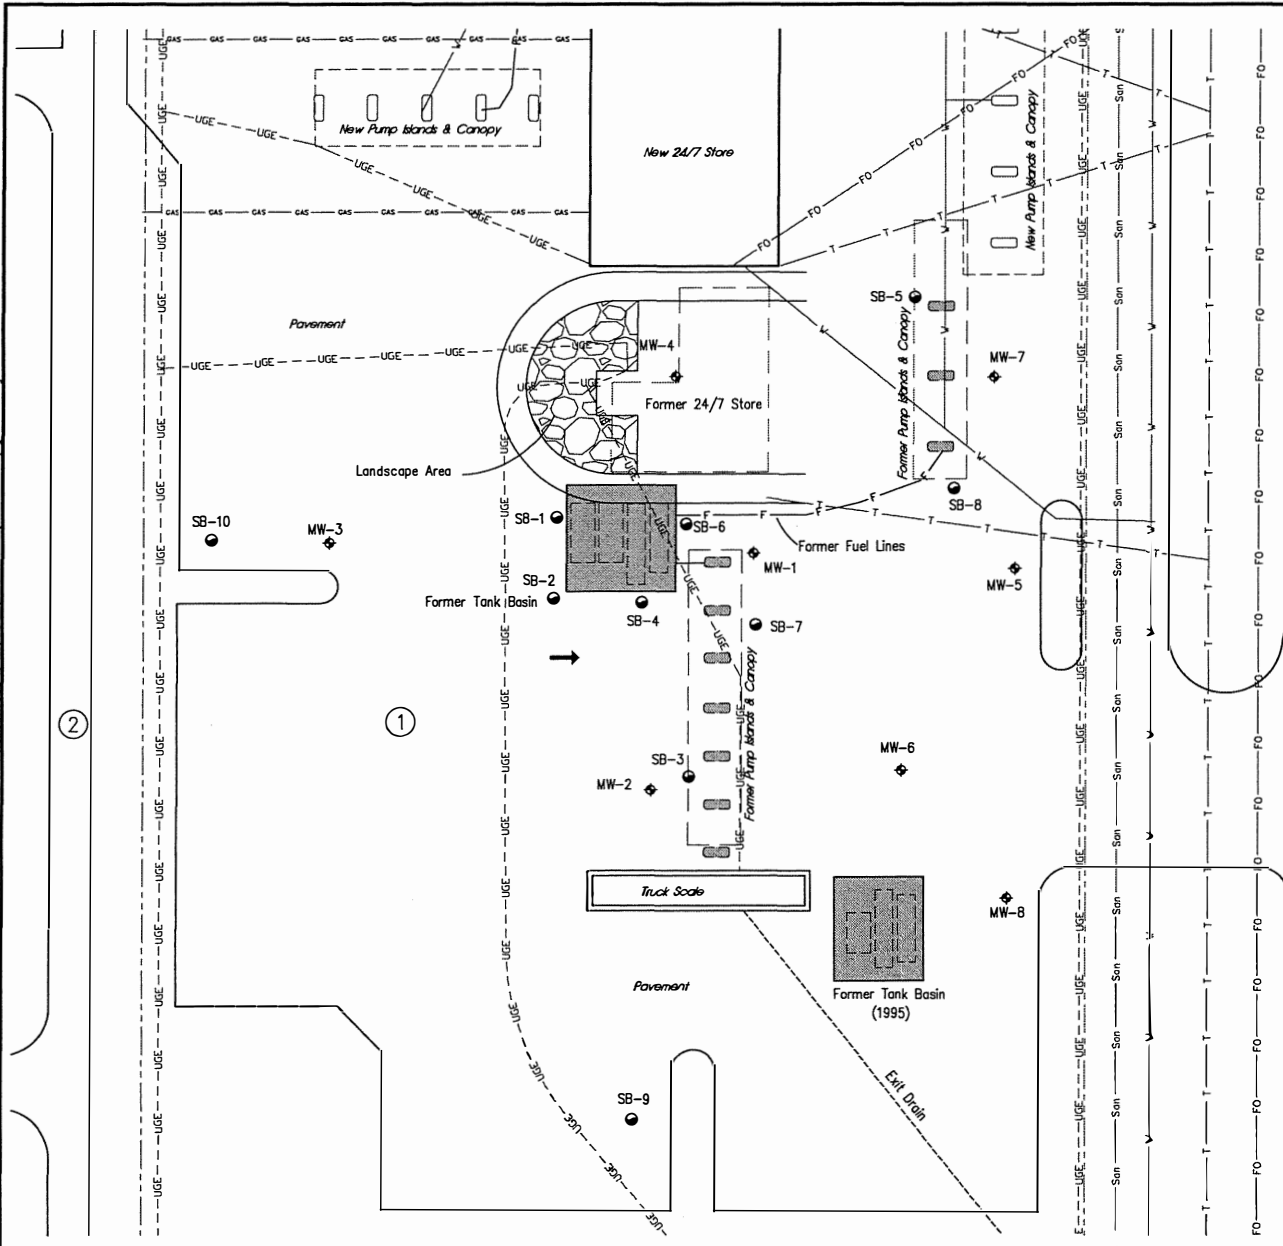


LEGEND

- ◆ = MONITORING WELL
- = SOIL BORING
- GAS = UNDERGROUND GAS
- UGE = UNDERGROUND ELECTRIC
- San = SANITARY SEWER
- W = WATER LINES
- T = TELEPHONE
- FO = UNDERGROUND FIBER OPTIC
- T = UNDERGROUND TELEPHONE
- F = FUEL LINE
- [Hatched Box] = FORMER TANK BASINS/PUMP ISLANDS
- [Diagonal Lines Box] = CURRENT TANK BASINS
- - - - - = APPROXIMATE ROW/PROPERTY LINES
- = GROUNDWATER FLOW DIRECTION

- NOTE:
SOIL BORINGS SB-9 & SB-10 WILL
BE USED SOLEY FOR COLLECTION
OF HYDROLOGIC SAMPLES
1. Property 6, LLC/Triplett, Inc - Goodland 24/7 Travel Store
 2. Karen Weber - Mid-America Camp Inn
 3. Prairie Breeze Capital, LLC - Steak n' Shake
 4. Prairie Sky Capital, LLC - Comfort Inn & Suites
 5. Prairie Springs Hospitality, LLC - Holiday Inn Express & Suites
- NOTE: NO BASEMENTS WERE LOCATED WITHIN 500 FEET.

NOTE:
FORMER FUEL LINE LOCATIONS ARE
ESTIMATED, NOT KNOWN.

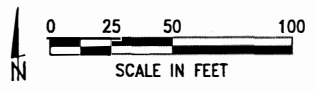

REVISIONS	BY

MILCO
Environmental
Services, Inc.
Hemph, NE (308) 237-6223
McCook, NE (308) 345-4741

GOODLAND 24-7 TRAVEL STORE
SITE BASE MAP
2710 COMMERCE ROAD, GOODLAND, KS - U6-091-15432

SCALE: AS SHOWN
PROJECT NO: M251-P24-03
DATE: MARCH 2023
FIELD BOOK: NANA DWG NO.
DRAWN BY: ESF
APPROV BY: [Signature]
SHEET

FIGURE 2.2