

WATER WELL RECORD Form WWC-5

Division of Water Resources App. No.

MW-8

Original Record Correction Change in Well Use

Well ID

1 LOCATION OF WATER WELL: County: Sherman Fraction NE 1/4 NE 1/4 SE 1/4 SE 1/4 Section Number 25 Township Number T 8 S Range Number R 40 E W

2 WELL OWNER: Last Name: Business: Triplett, Inc Address: PO Box 647 City: Salina State: KS ZIP: 67402 Street or Rural Address where well is located: 2710 Commerce Road, Goodland

3 LOCATE WELL WITH 'X' IN SECTION BOX: [Diagram] 4 DEPTH OF COMPLETED WELL: 231 ft. 5 Latitude: 39.325316 Longitude: 101.726687

7 WELL WATER TO BE USED AS: 1. Domestic: 2. Irrigation 3. Feedlot 4. Industrial 5. Public Water Supply 6. Dewatering 7. Aquifer Recharge 8. Monitoring MW-8 9. Environmental Remediation 10. Oil Field Water Supply 11. Test Hole 12. Geothermal 13. Other

Was a chemical/bacteriological sample submitted to KDHE? Water well disinfected?

8 TYPE OF CASING USED: Steel PVC Other CASING JOINTS: Glued Clamped Welded Threaded Casing diameter 4 in. to 231 ft. TYPE OF SCREEN OR PERFORATION MATERIAL: Steel Stainless Steel Fiberglass PVC Brass Galvanized Steel Concrete tile None used

9 GROUT MATERIAL: Neat cement Cement grout Bentonite Other Grout Intervals: From 1 ft. to 196 ft.

Nearest source of possible contamination: Septic Tank Lateral Lines Pit Privy Livestock Pens Insecticide Storage Sewer Lines Cess Pool Sewage Lagoon Fuel Storage Abandoned Water Well Watertight Sewer Lines Seepage Pit Feedyard Fertilizer Storage Oil Well/Gas Well

10 FROM TO LITHOLOGIC LOG FROM TO LITHO. LOG (cont.) or PLUGGING INTERVALS


11 CONTRACTOR'S OR LANDOWNER'S CERTIFICATION: This water well was constructed, reconstructed, or plugged under my jurisdiction and was completed on (mo-day-year) 2/20/2023

Twp. 8 Rge. 40W Sec. 25

County: Sherman

KDHE: Goodland 24-7 Travel Store, U6-091-15432

Plotfile: 3/29/2023 10:58 AM SAVED: 3/30/2023 10:44 AM Brian S. Fahrbrunh g:\Projects\251\251-FV24-03\LSA\_3-2023\Figure 2.2.dwg

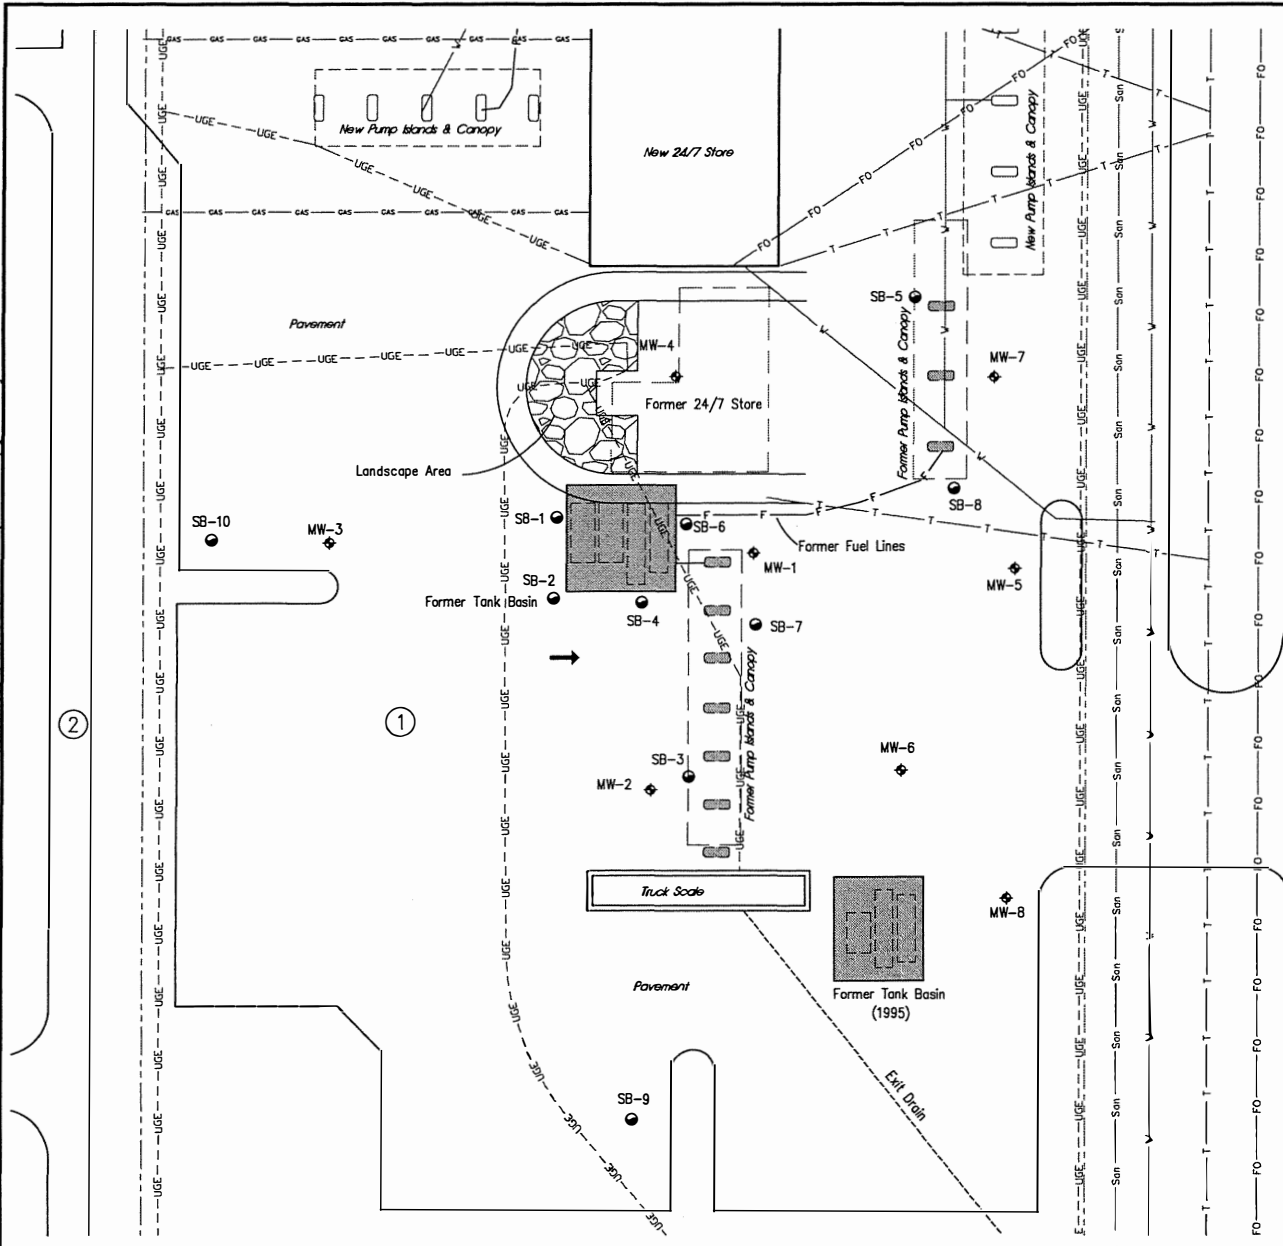


**LEGEND**

- ⊕ = MONITORING WELL
- = SOIL BORING
- GAS = UNDERGROUND GAS
- UGE = UNDERGROUND ELECTRIC
- SW = SANITARY SEWER
- W = WATER LINES
- F = FENCE
- FO = UNDERGROUND FIBER OPTIC
- T = UNDERGROUND TELEPHONE
- F = FUEL LINE
- [Hatched Box] = FORMER TANK BASINS/PUMP ISLANDS
- [Diagonal Lines Box] = CURRENT TANK BASINS
- - - - - = APPROXIMATE ROW/PROPERTY LINES
- = GROUNDWATER FLOW DIRECTION

- NOTE:  
SOIL BORINGS SB-9 & SB-10 WILL  
BE USED SOLEY FOR COLLECTION  
OF HYDROLOGIC SAMPLES
- Property 6, LLC/Triplett, Inc - Goodland 24/7 Travel Store
  - Karen Weber - Mid-America Camp Inn
  - Prairie Breeze Capital, LLC - Steak n' Shake
  - Prairie Sky Capital, LLC - Comfort Inn & Suites
  - Prairie Springs Hospitality, LLC - Holiday Inn Express & Suites
- NOTE: NO BASEMENTS WERE LOCATED WITHIN 500 FEET.

NOTE:  
FORMER FUEL LINE LOCATIONS ARE  
ESTIMATED, NOT KNOWN.

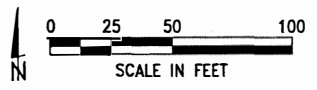

REVISIONS	BY

**MILCO**  
Environmental  
Services, Inc.  
Hawley, NE (408) 237-6223  
McCook, NE (408) 345-4141

GOODLAND 24-7 TRAVEL STORE  
**SITE BASE MAP**  
2710 COMMERCE ROAD, GOODLAND, KS - U6-091-15432

SCALE: AS SHOWN  
PROJECT NO: M251-P24-03  
DATE: MARCH 2023  
FIELD BOOK: HANA DWG NO.  
DRAWN BY: ESF  
APPROV BY: [Signature]  
SHEET

**FIGURE 2.2**