T23S-R34W

"ASBUILT"

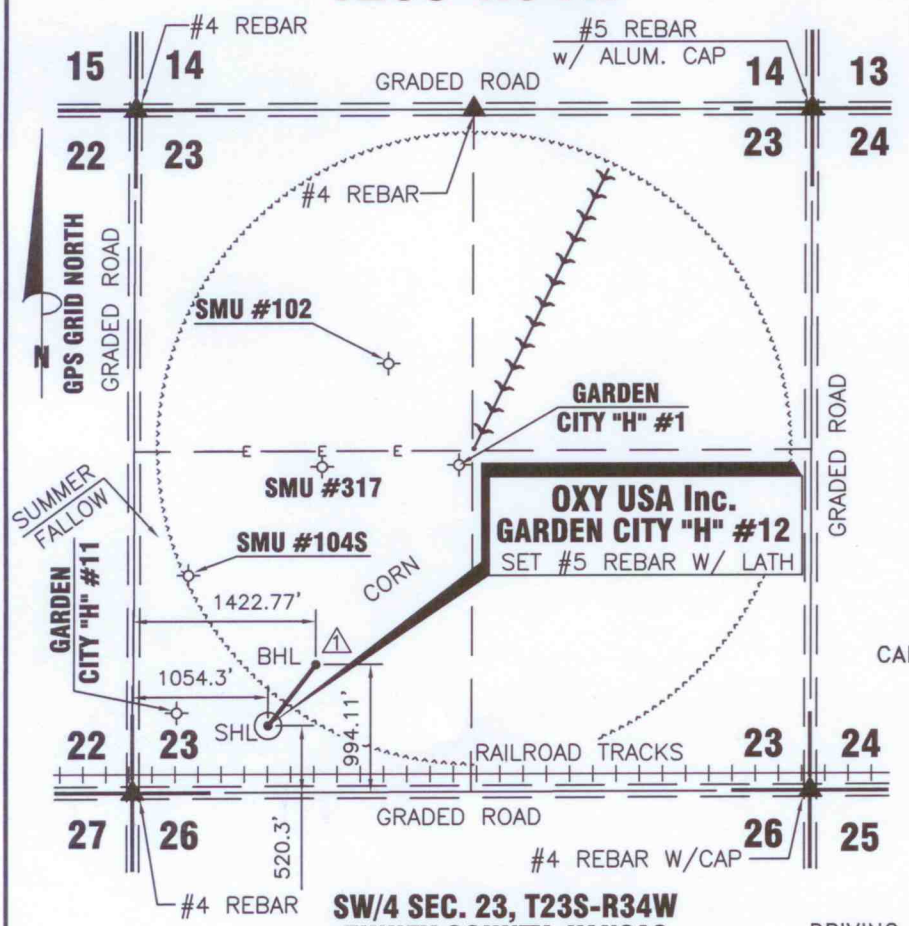

SW/4 SEC. 23, T23S-R34W
FINNEY COUNTY, KANSAS

DATE **5/2/2013**

OPERATOR **OXY U.S.A.**

WELL NAME **GARDEN CITY "H" #12**

LOCATION **SW/4 SEC.23, T23S-R34W**

SURFACE HOLE LOCATION

FOOTAGES & **520.3'** F **S** L

RELATIONS **1054.3'** F **W** L

ELEVATION **2941.26'**

BOTTOM HOLE LOCATION

FOOTAGES & △1 **994.11'** F **S** L

RELATIONS △1 **1422.11'** F **W** L

CALC. ELEVATION △1 **-2052.79'**

DISTANCE TO EXISTING WELL
719.35' **GARDEN CITY "H" #11**

AUTHORIZED BY **BETH HICKERT**

CROP **SUMMER FALLOW**

SURFACE HOLE LOCATION

LATITUDE **38°02'02.11314" N =38.033920° N**

LONGITUDE **101°01'31.45329" W =101.025404° W**

STATE PLANE COORD.
KANSAS SOUTH ZONE
NAD 27
X =1272721.60
Y =507688.36

BOTTOM HOLE LOCATION

LATITUDE **38°02'06.80484" N =38.035224° N** △1

LONGITUDE **101°01'26.82419" W =101.024118° W** △1

STATE PLANE COORD.
KANSAS SOUTH ZONE
NAD 27
X =1273104.67 △1
Y = 508152.71 △1

DRIVING DIRECTIONS USED TO STAKE WELL FROM KNOWN LANDMARK OR CITY FROM:

FROM THE INTERSECTION OF HWY #50 & FAS #1657, 2.0 MILES WEST OF HOLCOMB, KS; THENCE NORTH 2.1 MILES ON FAS #1657; THENCE EAST 1054.3 FT. INTO.

NOTE: CONTRACTOR TO CONTACT ONE CALL @ 1-800-DIG SAFE PRIOR TO ANY EXCAVATION OR CONSTRUCTION.

THEODORE V. HARDER
LICENSED
10-7-2013
LS-1097
KANSAS
LAND SURVEYOR

Theodore V. Harder, P.L.S. No. 1097

OXY USA Inc.
1117 N. HIGHWAY 27
P.O. DRAWER 330
ELKHART, KANSAS 67950
(620)697-2500

WELL LOCATION OF THE GARDEN CITY "H" #12
LOCATED IN THE SW/4 SEC. 23, T23S - R34W
FINNEY COUNTY, KANSAS

DRAWN BY:	CHECKED BY:	APPROVED BY:	AUTHORIZED BY:
DRF	TVH		B. HICKERT

NO.	DWN.	REVISIONS	DATE
△1	DRF	ASBUILT BOTTOM HOLE LOCATION	10/2/2013

SCALE: 1"=1500' DATE: 5/2/2013
WORK ORDER NO.:

HARDER
AND ASSOCIATES "locating our world"
LAND SURVEYING - GPS SPECIALISTS
P.O. BOX 518 514 MORTON
Elkhart, Kansas 67950
Phone: (620) 697-2696
Fax: (620) 697-4175
E-MAIL: tharder@elkhart.com
CO KS NM OK

DRAWING NO. OX0313A08