


Actual Bottom-Hole Location of Lori 1-2H
Barber County, Kansas
T&R: 34S 10W
Section: 35, 614' FWL & 2307' FSL
Long/Lat:-98.38156 37.042198
1 in = 1,042 ft

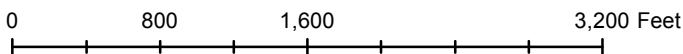

Draftsman: Aaron Birk	Draft Date: 4/10/2012
Drawing Name/Number: Addendum_Lori_1-2H.mxd	
Coordinate System: NAD 1927 State Plane Kansas South FIPS: 1502	

- Actual BH Location
- SandRidge Wells
- Perf
- Sections