




WELL : Marple Living Trust 5-1
 FIELD : Cherokee Basin
 STATE : Kansas
 COUNTY : Wilson

SPUD DATE : 6/14/2004
 COMP. Date : 7/26/2004
 API: 15-205-25814

LOCATION: 5-28S-17E (NE SW NE SE)
 ELEVATION: GL - 1004'

8 5/8" 24.75 LB @ 21.5' Cement w/4 sks

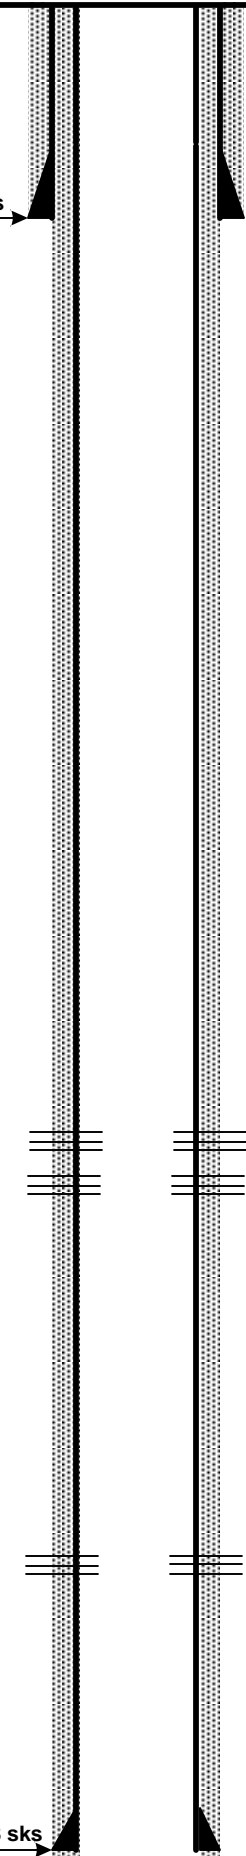

4.5" 10.5 lb @ 1069.8' Cement w/138 sks

Drilled Depth @ 1190'

Wellhead/Surface Equipment

| | |
|-----------------|--|
| Tree Connection | |
| Tree | |
| Tubing Head | |
| Bradenhead | |
| Pumping Unit | |
| Compressor | |

Tubular Detail

| Size | Weight | Grade | Cap(bbl/ft) | Date | Depth |
|--------|---------|-------|-------------|------|---------|
| 8 5/8" | 20 lb | | | 2006 | 22.7' |
| 4 1/2" | 10.5 lb | | .0159 | 2006 | 1069.8' |
| | | | | | |
| | | | | | |
| | | | | | |
| | | | | | |

Downhole Equipment Detail

Completion Data

| |
|---------------------------------|
| Original as GAS Well per ACO-1s |
| 600 gals 15% HCL |
| 436 bbls HEC water |
| 16,548 lbs 20/40 sand |

Perforations

| |
|----------------------------|
| <u>Original Completion</u> |
| 705 – 708 (13) |
| 716.5 – 719.5 (13) |
| <u>2012</u> |
| 990 – 998 (6) |

POSTROCK



LEGEND

PostRock®

