PR ΑP

POSTROCK



Current Completion

WELL : McMillen, Billy D 30-1 **FIELD** : Cherokee Basin CBM


COMP. Date: 2/6/2006 API: 15-205-26734-00-00

SPUD DATE: 6/14/2006

STATE : Kansas COUNTY : Wilson

LOCATION: 30-28S-17E (NE, NE)

ELEVATION: GL - 882'

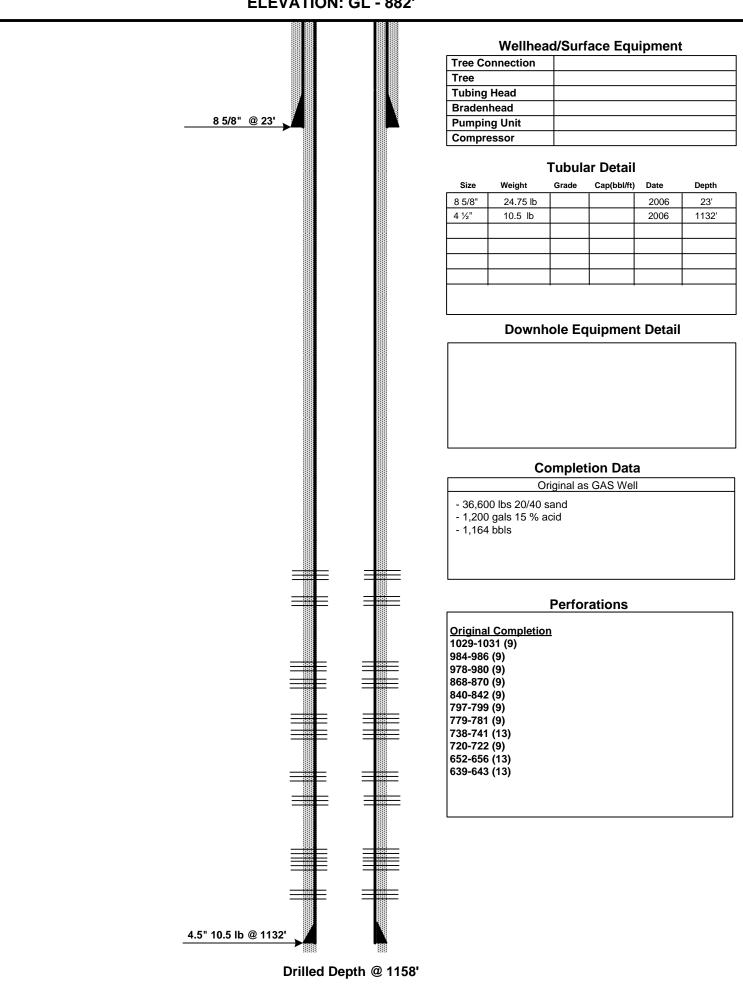

PREPARED BY: POSTROCK

APPROVED BY: _

DATE: June, 2012

DATE:

POSTROCK



LEGEND

PostRock[®]

