


WELL : Erbe, Monte 36-1  
 FIELD : Cherokee Basin  
 STATE : Kansas  
 COUNTY : Wilson

SPUD DATE : 10/27/2004  
 COMP. Date : 10/28/2004  
 API: 15-205-25890-00-00

LOCATION: 36-29S-16E (NW, SE)  
 ELEVATION: GL - 822'

8 5/8" 24.75 lb @ 21.5' Cement w/6 sks

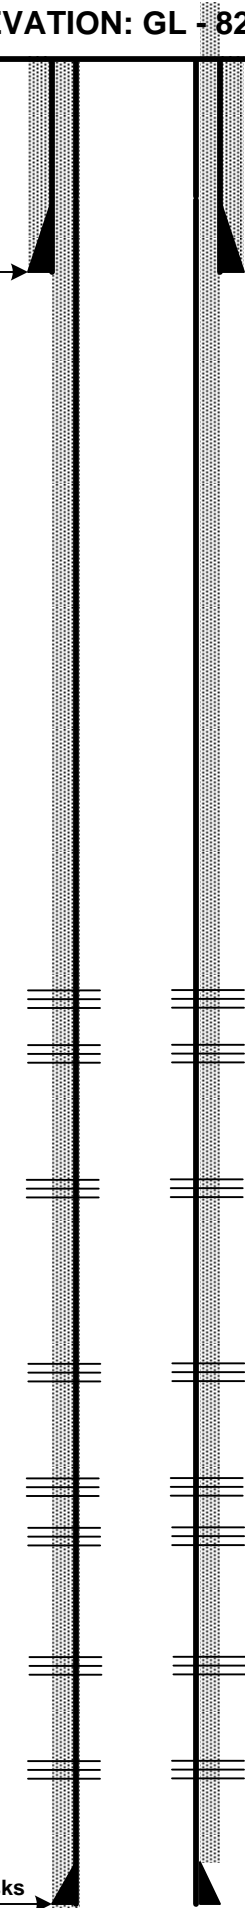

4.5" 10.5 lb @ 1035' Cement w/116 sks

Drilled Depth @ 1037'

Wellhead/Surface Equipment

Tree Connection	
Tree	
Tubing Head	
Bradenhead	
Pumping Unit	
Compressor	

Tubular Detail

Size	Weight	Grade	Cap(bbl/ft)	Date	Depth
8 5/8"	24.75 lb			2003	21.5'
4 1/2"	10.5 lb		.00159	2003	1035'

Downhole Equipment Detail


Completion Data

Original as GAS Well per ACO-1s
- 26,390 lbs 20/40, 16/30 sand mix
- 1,200 gal 15%
- 1055 bbls

Perforations

Original Completion (2004)
593-597.5 (19)
576-579.5 (17)
OWWO (8/2006)
987-989 (9)
942-944 (9)
768-770 (9)
648-651 (13)
4/9/2012 (Bartlesville Sand)
825-829
804-808

# POSTROCK



## LEGEND

PostRock®

