


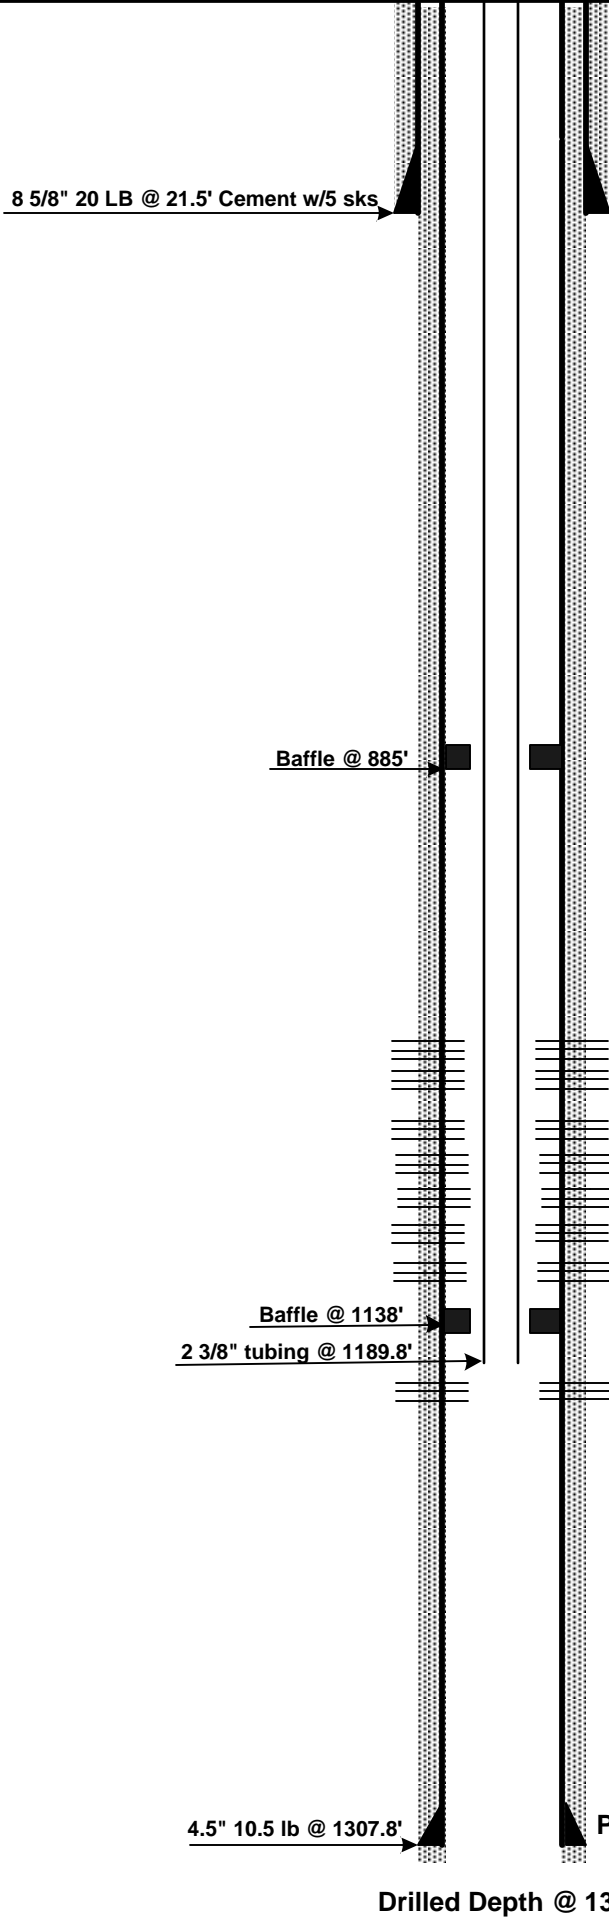

WELL : Campbell, Lois D 3-2
 FIELD : Cherokee Basin CBM
 STATE : Kansas
 COUNTY : Wilson

SPUD DATE : 6/5/06
 COMP. Date : 6/14/06
 RECOMP. Date : 5/2012

API: 15-205-26618
 LOCATION: 3-28S-16E (NE, SE)
 ELEVATION: GL - 1020'



Wellhead/Surface Equipment

Tree Connection	
Tree	
Tubing Head	
Bradenhead	
Pumping Unit	
Compressor	

Tubular Detail

Size	Weight	Grade	Cap(bbl/ft)	Date	Depth
8 5/8"	20 lb			2006	21.5'
4 1/2"	10.5 lb			2006	1307.8'
2 3/8"				2006	1189.8'

Downhole Equipment Detail

Small hole baffle used @ 885' (6/26/06)
 Large hole baffle used @ 1138' (6/22/06)

Completion Data

Original as GAS Well
 - 950 gals 15% HCL total
 - 27,500 lbs 20/40 sand total
 - 1,150 water

Perforations

Original:
 827 - 831 (4 spf)
 841 - 845 (4 spf)
 905 - 907 (4 spf)
 923 - 926 (4 spf)
 958 - 960 (4 spf)
 1072 - 1074 (4 spf)
 1194 - 1196 (4 spf)
 5/2012
 1082 - 1088 (3 spf)

POSTROCK



LEGEND

PostRock®

