### **POSTROCK**




## **Current Completion**

**WELL** : McCoy, Virginia 30-1 **FIELD** : Cherokee Basin CBM SPUD DATE: 1/23/2006 COMP. Date: 2/3/2006 API: 15-133-26469-00-00

**STATE** : Kansas **COUNTY** : Neosho

**LOCATION: 30-28S-19E (SW, NW)** 

**ELEVATION: GL - 904'** 

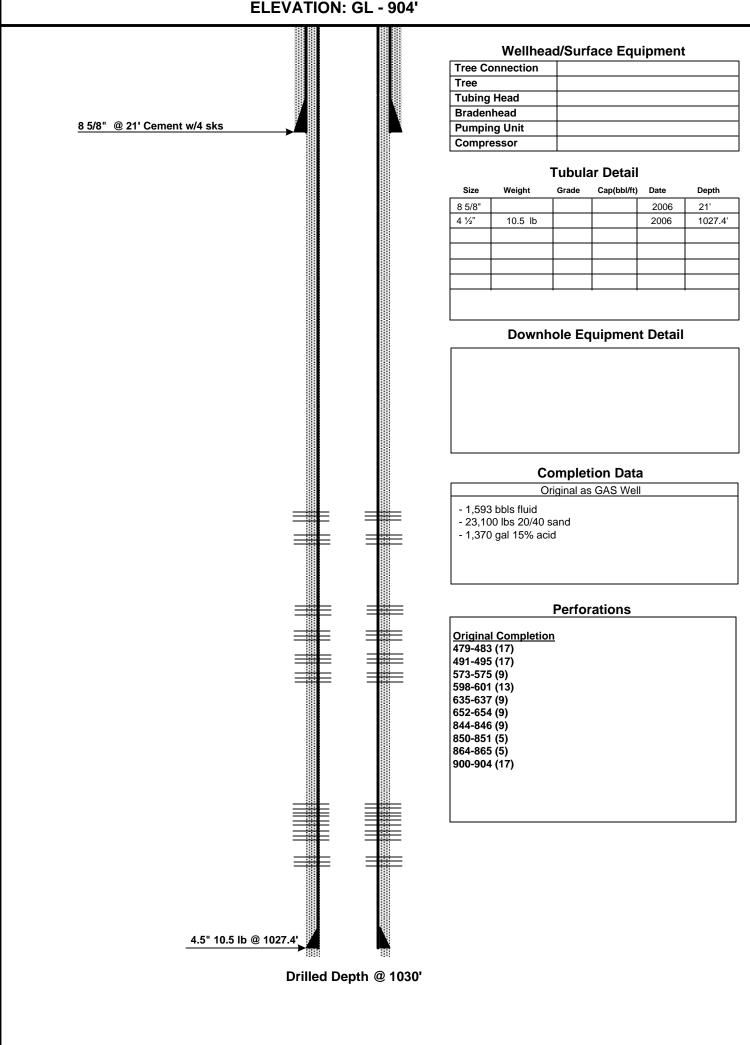

PREPARED BY: POSTROCK

APPROVED BY: \_

**DATE:** June, 2012

DATE:

# **POSTROCK**



#### **LEGEND**

### PostRock<sup>®</sup>

