


WELL : Kramer, Lois 1-3  
 FIELD : Cherokee Basin  
 STATE : Kansas  
 COUNTY : Neosho

SPUD DATE : 8/7/2007  
 COMP. Date : 8/15/2007  
 API: 15-133-27082-00-00

LOCATION: 1-30S-18E (SW, NE)  
 ELEVATION: GL -972'

8 5/8" 24 lb @ 22' Cement w/5 sks

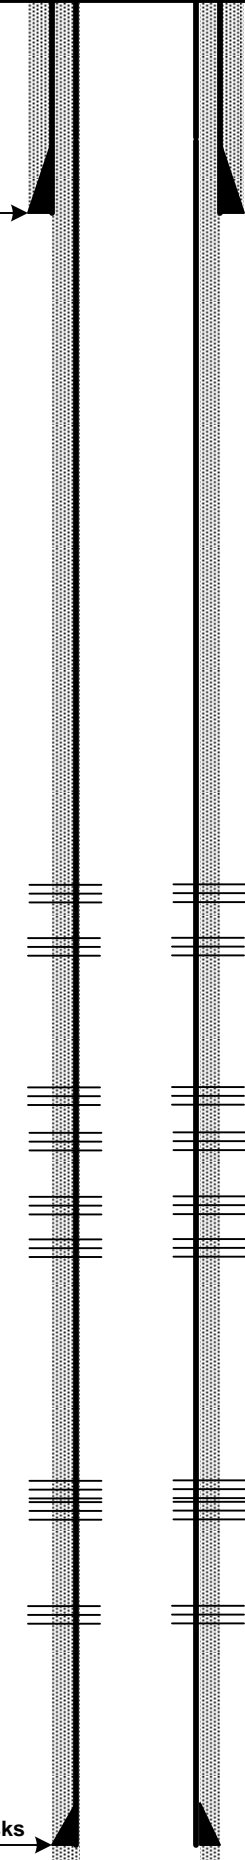

4.5" 10.5 lb @ 1052' Cement w/140 sks

Drilled Depth @ 1065'

**Wellhead/Surface Equipment**

Tree Connection	
Tree	
Tubing Head	
Bradenhead	
Pumping Unit	
Compressor	

**Tubular Detail**

Size	Weight	Grade	Cap(bbl/ft)	Date	Depth
8 5/8"	32lb			2007	22'
4 1/2"	10.5 lb		.0159	2007	1051'

**Downhole Equipment Detail**


**Completion Data**

Original as GAS Well
- 18,700 lbs 20/40 sand
- 900 gals 15% acid
- 1,976 bbls

**Perforations**

Original Completion (2007)
951-954 (13)
896-898 (9)
890-892 (9)
670-672 (9)
633-636 (13)
610-612 (9)
521-525 (17)
509-513 (17)
4/3/2012
692-698

# POSTROCK



## LEGEND

PostRock®

