


WELL : Kramer, Lois 1-1
FIELD : Cherokee Basin
STATE : Kansas
COUNTY : Neosho

SPUD DATE : 6/3/2003
COMP. Date : 6/30/2003
API: 15-133-25926-00-00

LOCATION: 1-30S-18E (NE, NE)
ELEVATION: GL - 964'

8 5/8" 32 lb @ 20' Cement w/4 sks

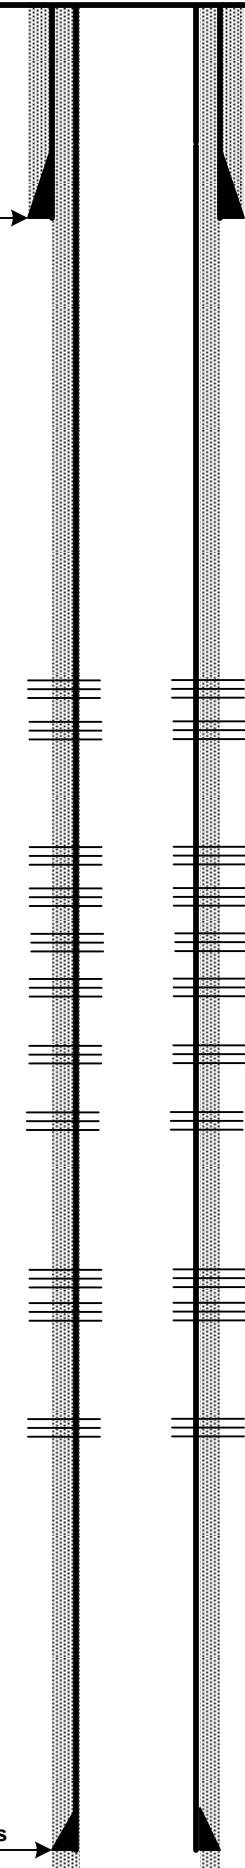

Drilled Depth @ 1148'

Wellhead/Surface Equipment

Tree Connection	
Tree	
Tubing Head	
Bradenhead	
Pumping Unit	
Compressor	

Tubular Detail

Size	Weight	Grade	Cap(bbl/ft)	Date	Depth
8 5/8"	32lb			2003	20'
5 1/2"	14lb		.0244	2003	1040'

Downhole Equipment Detail

--

Completion Data

Original as GAS Well per ACO-1s
- 16,000 lbs 20/40 sand
- 25,000 Fe HCL
- 2,576 bbls

Perforations

Original Completion (2003)
943-946 (4 spf)
890-892 (4 spf)
884-886 (4 spf)
764-773 (4 spf)
731-734 (4 spf)
662-666 (4 spf)
626-630 (4 spf)
602-605 (4 spf)
519-523 (4 spf)
507-511 (4 spf)
<u>4/3/12</u>
690-695

5.5" 14 lb @ 1040' Cement w/160 sks

POSTROCK



LEGEND

PostRock®

