




WELL : Mih, Mariam L 34-1
 FIELD : Cherokee Basin
 STATE : Kansas
 COUNTY : Neosho

SPUD DATE : 9/7/2004
 COMP. Date : 9/14/2004
 API: 15-133-26155-00-00

LOCATION: 34-27S-19E (NE,SE)
 ELEVATION: GL - 990'

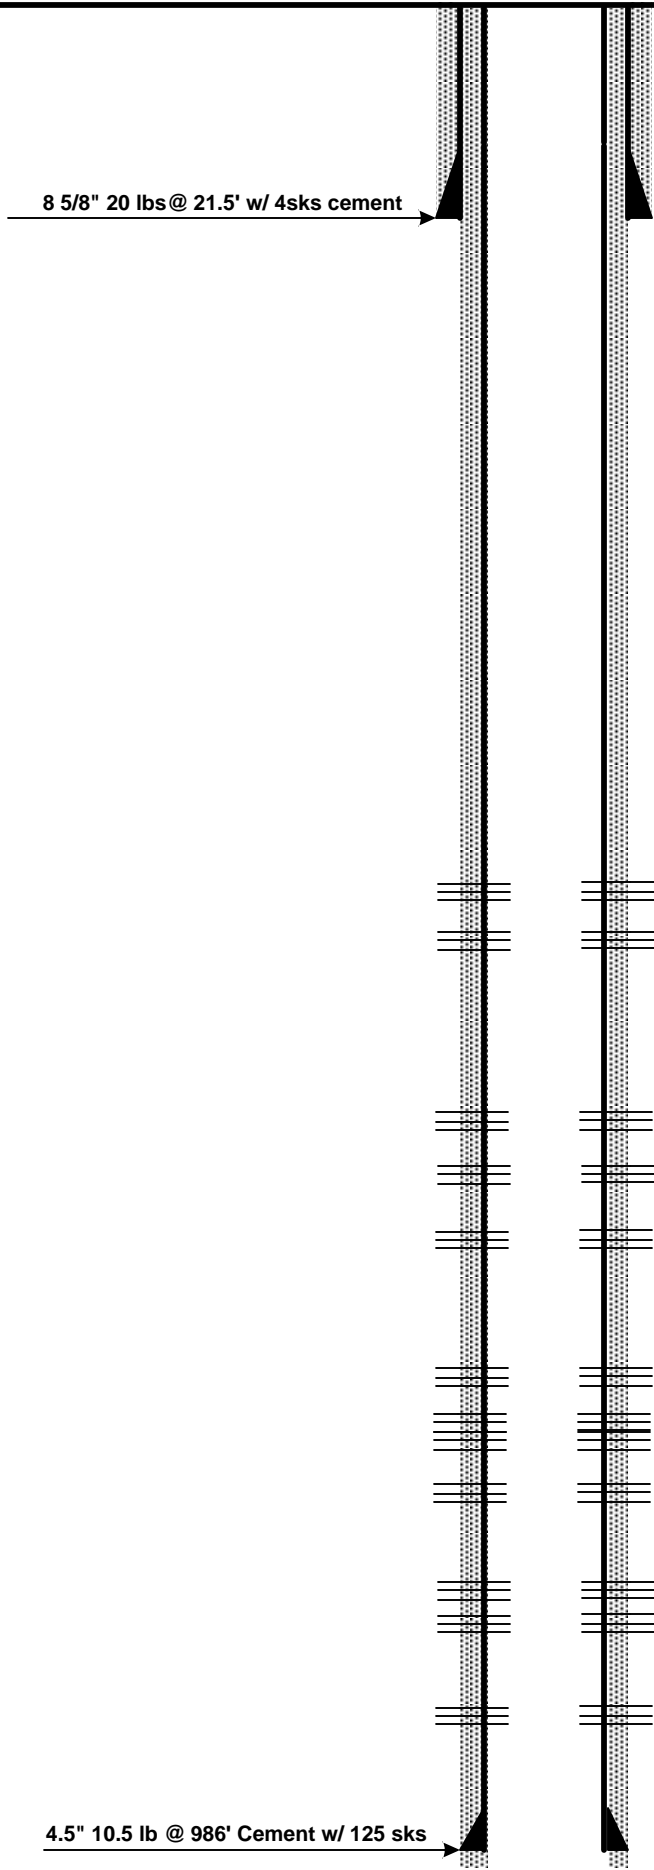

Wellhead/Surface Equipment

Tree Connection	
Tree	
Tubing Head	
Bradenhead	
Pumping Unit	
Compressor	

Tubular Detail

Size	Weight	Grade	Cap(bbl/ft)	Date	Depth
8 5/8"	20 lb			2004	21.5'
4 1/2"	10.5lb	J-55	0.0159	2004	986'

Downhole Equipment Detail

--

Completion Data

Original as GAS Well
- 25,500 lbs 20/40 sand
- 1,600 gals 15% acid
- 2,170 bbls

Perforations

Original Perfs (12/23/2004)
925-928 (13)
872-874 (9)
867-869 (9)
OWWO (5/29/2008)
770-772 (9)
722-724 (9)
664-666 (9)
626-629 (13)
602-604 (9)
519-523 (17)
507-511 (17)
Bartlesville Sand Frac 4/2/2012
756-764
742-748

POSTROCK



LEGEND

PostRock®

