


WELL : Moorhead, Michael W 6-1
 FIELD : Cherokee Basin CBM
 STATE : Kansas
 COUNTY : Wilson

SPUD DATE : 4/10/2007
 COMP. Date : 5/30/2007
 API: 15-205-27078-00-00

LOCATION: 6-29S-15E (NE, SE)
 ELEVATION: GL - 948'

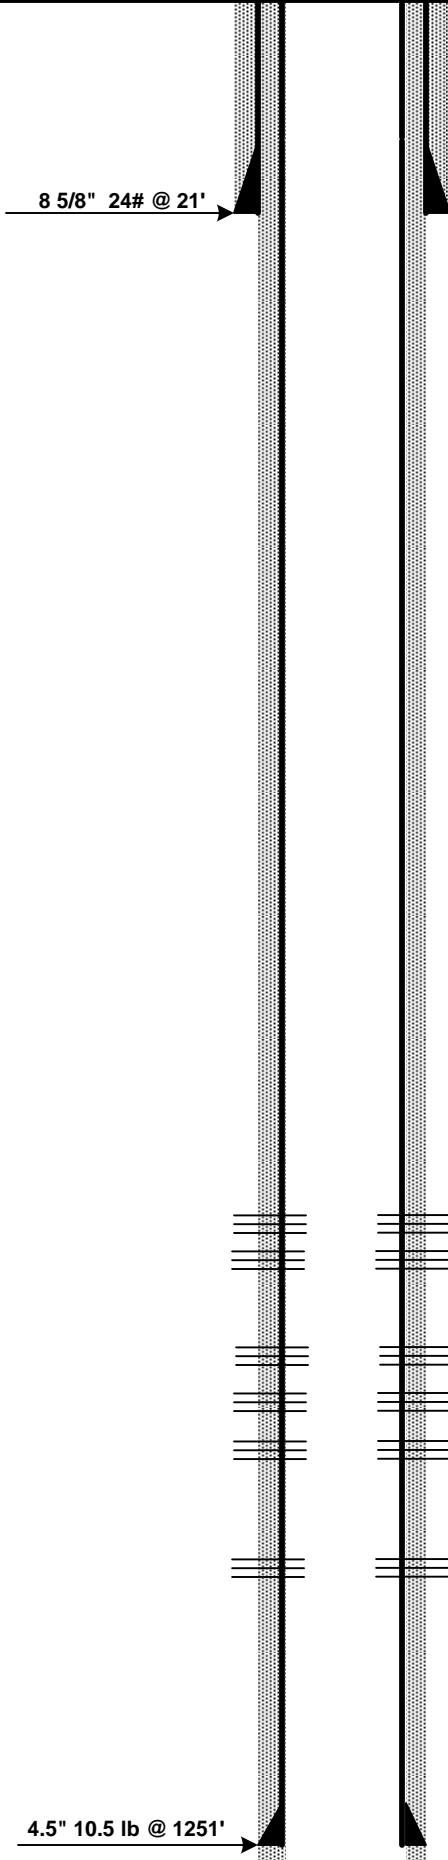

Wellhead/Surface Equipment

Tree Connection	
Tree	
Tubing Head	
Bradenhead	
Pumping Unit	
Compressor	

Tubular Detail

Size	Weight	Grade	Cap(bbl/ft)	Date	Depth
8 5/8"	24 lb			2007	21'
4 1/2"	10.5 lb			2007	1251.7'

Downhole Equipment Detail

Completion Data

Original as GAS Well
- 19,700 lbs 20/40 sand
- 600 gals 15% acid
- 1209 bbls

Perforations

Original Completion
984-986 (9)
943-946 (13)
925-927 (9)
868-872 (17)
854-858 (17)
1098-1110 4/18/2012

Drilled Depth @ 1262'

POSTROCK



LEGEND

PostRock®

