WELL NAME: Ronnie Evans 1- 36H DATE: 3/5/2012 PRESENT: X PROPOSED:

COMPANY: Reeder Energy FIELD:

API No. 15-025-21536-00-00 COUNTY: Comanche County STATE: KS

TYPE OF WELL: Oil COMPLETION: Mississipi Lime

TD: 10195 PBTD: SPUD DATE: 1/5/2012 COMPLETION DATE: 2/25/2012

GL ELEV: 2256' DF: KB: 17'

OPEN HOLE LOGS	CASED HOLE LOGS
Triple Combo	

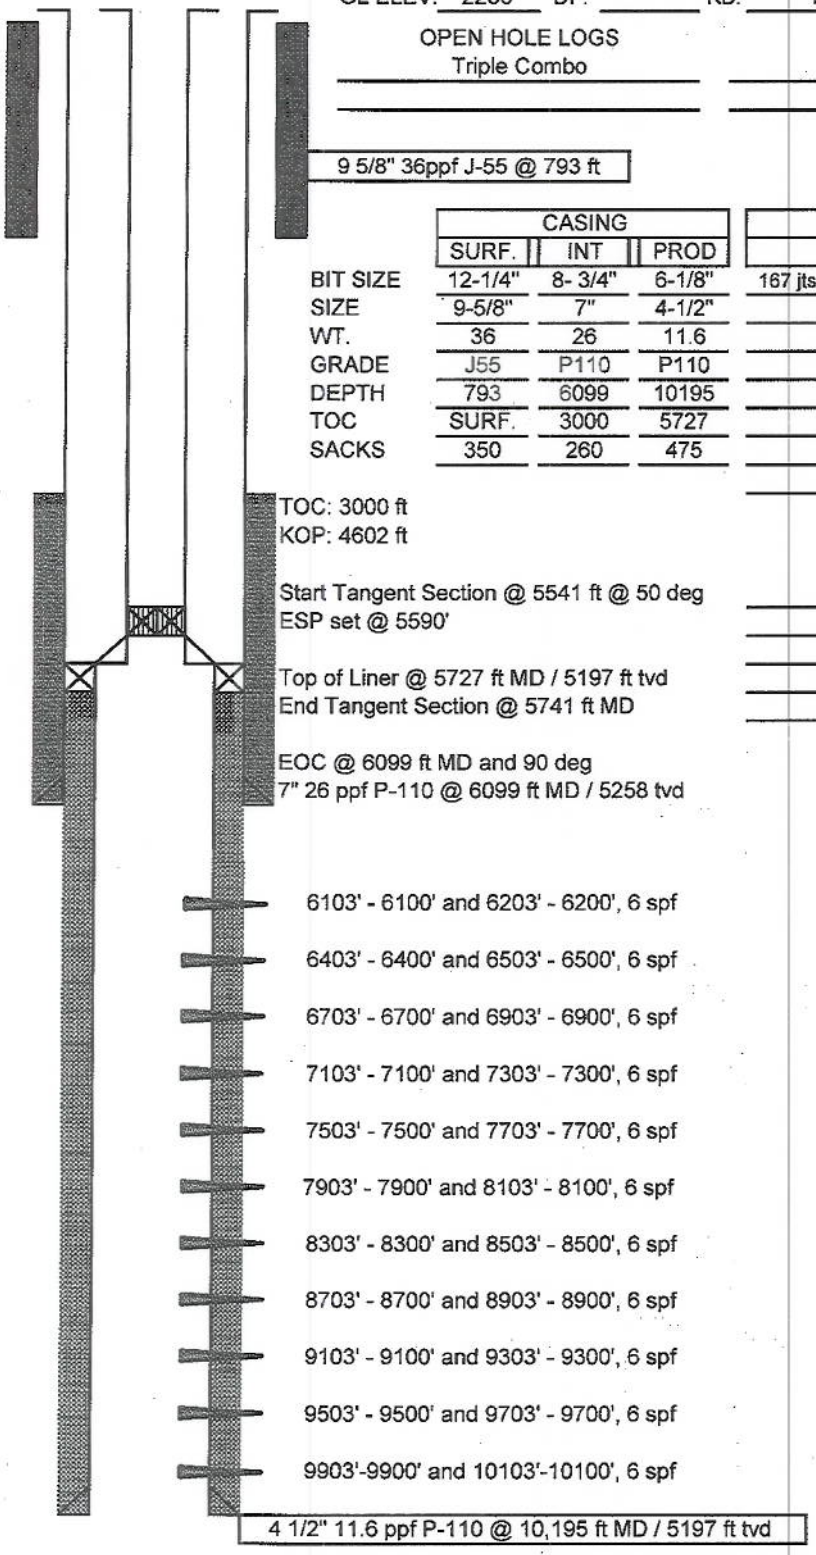

CASING	SURF.	INT	PROD
BIT SIZE	12-1/4"	8- 3/4"	6-1/8"
SIZE	9-5/8"	7"	4-1/2"
WT.	36	26	11.6
GRADE	J55	P110	P110
DEPTH	793	6099	10195
TOC	SURF.	3000	5727
SACKS	350	260	475

TUBING MAKEUP		
DATUM	LENGTH	DEPTH
167 jts, 2-7/8", 6.4 ppf, EUE, N-80	5513.28	5513.28
ESP Assembly	76.72	5590.00

ARTIFICIAL LIFT		
DESCRIPTION	LENGTH	DEPTH