


X/Y:
Feet

1688900

264000

264000

1688900

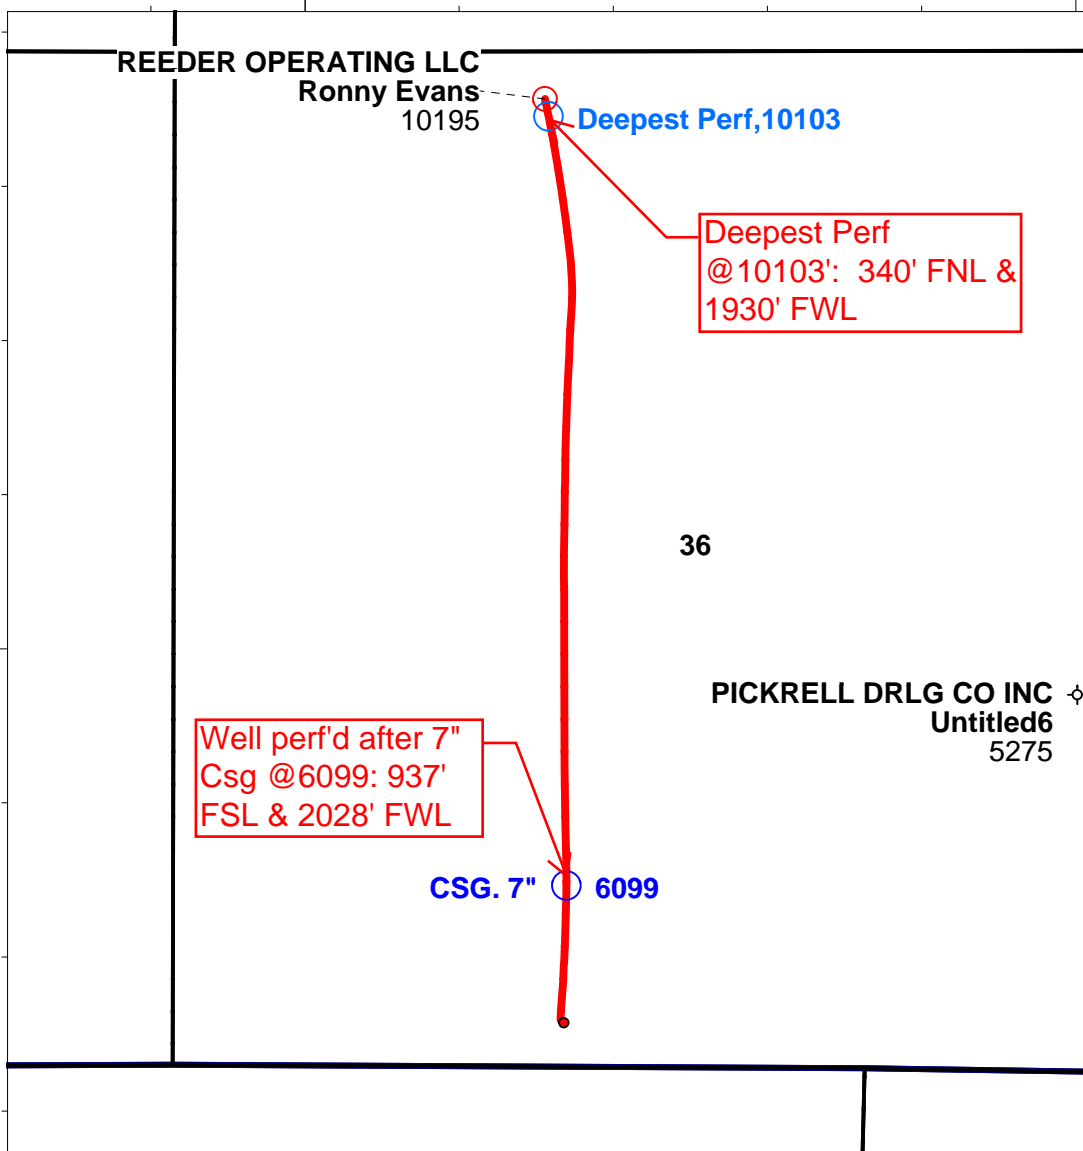

Reeder Operating LLC

Plat Map- Ronny Evans 1-36H

Clark Co., KS

Scale = 1:11957



Base Map