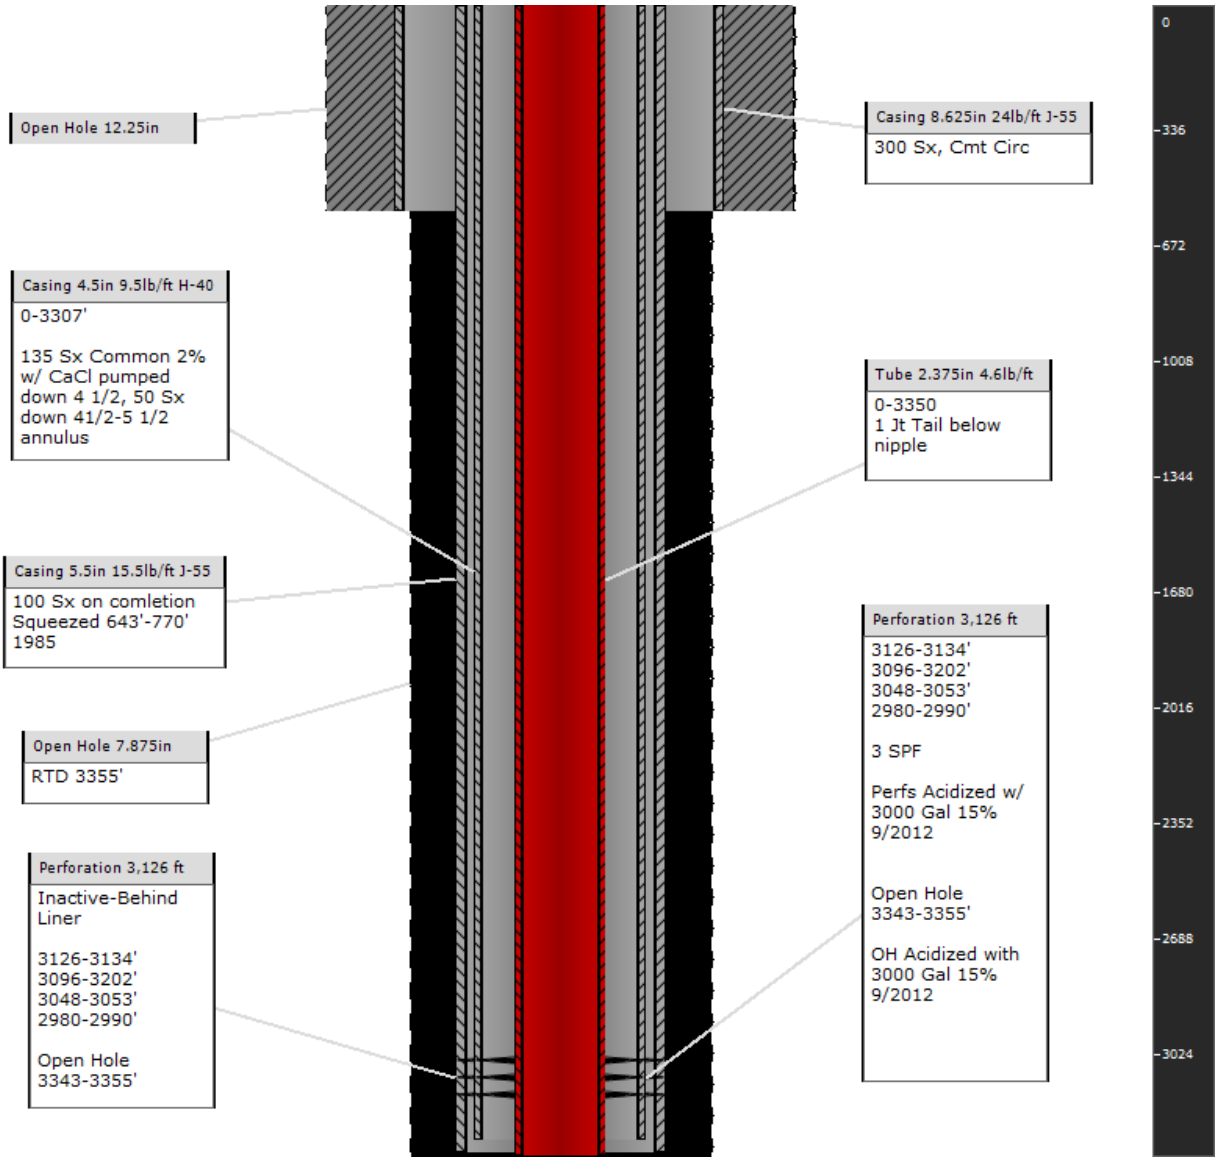

Measured Depth - 3355 ft

Legend:

Open Hole

Tubing

Casing

Perforation