



Current


Spud: 9/5/2011

Field: Waldron West
 County: Barber
 State: Kansas
 Well: Robert 1-13H
 Location: SEC 13, TWP 35N, RGE 11W
 KB: 1325'
 GL: 1303'

Wellbore Schematic
 1500-723-75601
 API No.

Original Completion (10-13-2011) X
 Current
 Proposed

Well Bore Data MD TVD

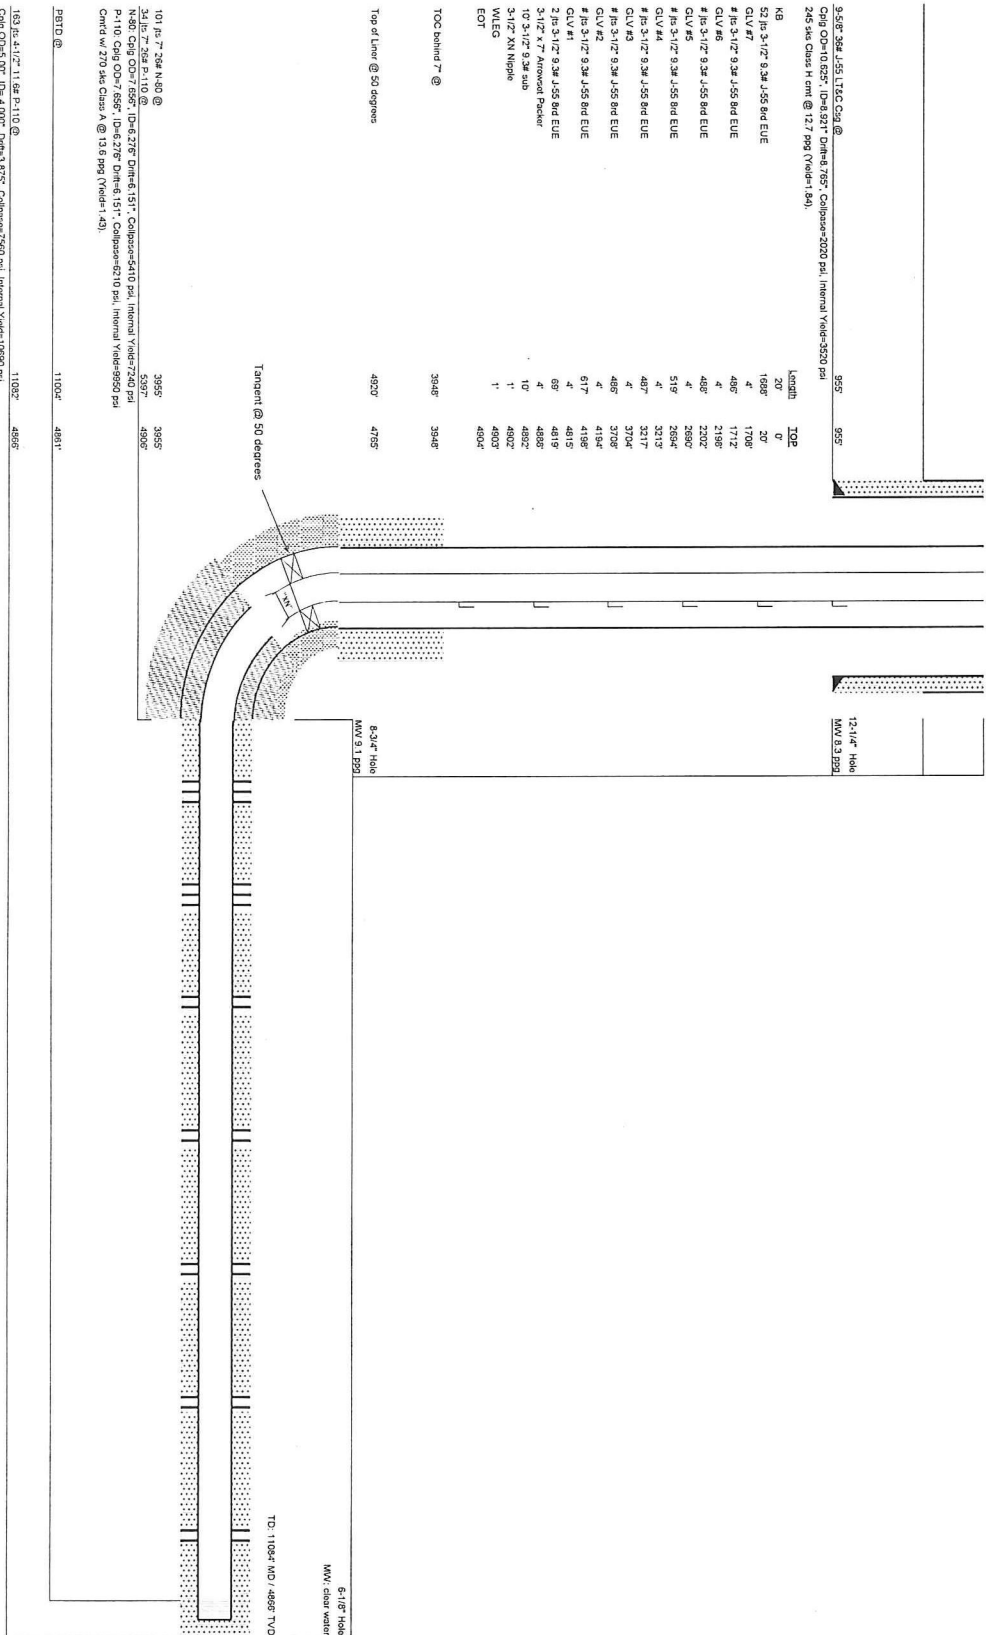

KB	Length	TOP
52 # 3-1/2" 9.3# J-55 8nd EUE	20'	0'
CLV #7	1688'	20'
# 1# 3-1/2" 9.3# J-55 8nd EUE	4'	1708'
# 1# 3-1/2" 9.3# sub	1'	4902'
WILEG	1'	4903'
EOT		4904'

TOC behind 7" @ 3948' 3948'

Top of liner @ 50 degrees 4920' 4755'






PERD @ 11004' 4881'

11082' 4885'

183 # 4-1/2" 11.8# P-110 @ 11082'


