

Section 1 SCHROCK I-1H
35S 11W*

Section 6
35S 10W

1480' FNL

643' FEL

BHL: 4866'
-98.459418, 37.017016

Bottom Perf: 4862'
-98.459371, 37.016711

Section 11
35S 11W

Section 12
35S 11W

Section 7
35S 10W

Section 14
35S 11W

Section 13
35S 11W

Section 18
35S 10W

Top Perf: 4828'
-98.459451, 37.000404

ROBERT 1-13H



Section 15
29N 12W

Section 14
29N 12W

Section 13
29N 12W



Actual Bottom-Hole Location of Robert 1-13H
Barber County, Kansas

T&R: 35S 11W

Section: 12 & 13, 1480' FNL & 643' FEL

Long: -98.459418, Lat: 37.017016

1 in = 990 ft




● Actual BH Location

* SandRidge Wells

----- Perf

□ Sections

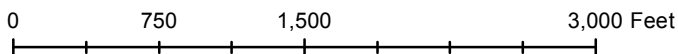

Draftsman:

Matt White

Draft Date: 1/26/2012

Drawing Name/Number:

Addendum_Robert_1-13H.mxd

Coordinate System:

NAD 1927 State Plane
Kansas South FIPS: 1502