

BHL: 11024'

-98.449872 37.054723

Bottom Perf: 10912'

-98.449887 37.054416

2189' FWL

Section 30
34S 10W

1694' FSL

Section 25
34S 11W

Section 36
34S 11W

Section 31
34S 10W

Top Perf: 5050'
-98.44946 37.038343

Miss Entry: 5030
-98.449462 37.038291

ROARK 1-31H

Section 1
35S 11W

Section 6
35S 10W



Actual Bottom-Hole Location of Roark 1-31H
Barber County, Kansas

T&R: 34S 10W
Section: 30, 2189' FWL & 1694' FSL
Long/Lat: -98.449872 37.054723

1 in = 807 ft




● Actual BH Location

* SandRidge Wells

--- Perf

□ Sections

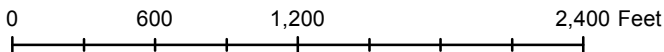

Draftsman:

Aaron Birk

Draft Date: 3/27/2012

Drawing Name/Number:

Addendum_Roark_1-31H.mxd

Coordinate System:

NAD 1927 State Plane
Kansas South FIPS: 1502