

Section 6
31S 19W

Section 5
31S 19W

LOHRDING 4A

ZIELKE 5-1

MURPHY 1-7H

Miss Entry: 5224'
-99.424474 37.364939

Top Perf: 5319'
-99.424455 37.364715

LOHRDING 3A

LOHRDING UNIT 2

Section 7
31S 19W

LOHRDING 8-1

Section 8
31S 19W

PATRICIA 7-1

Bottom Perf: 8987'
-99.424337 37.354760

BHL: 9415'
-99.424323 37.353596

390' FSL

1732' FEL

Section 18
31S 19W

Section 17
31S 19W



Actual Bottom-Hole Location of Murphy 1-7H
Comanche County, Kansas
T&R: 31S 19W
Section: 7, 1732' FEL & 390' FSL
Long/Lat: -99.424323 37.353596

1 in = 833 ft




● Actual BH Location

* SandRidge Wells

--- Perf

□ Sections

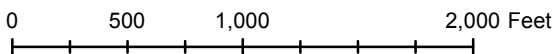

Draftsman:

Aaron Birk

Draft Date: 7/5/2012

Drawing Name/Number:

Addendum_Murphy_1-7H.mxd

Coordinate System:

NAD 1927 State Plane
Kansas South FIPS: 1502