

Section 12
21S 24W

Section 7
21S 23W

405' FNL
BHL: 8845'
-99.898559 38.232205
329' FWL

Bottom Perf: 8340'
-99.898543 38.230818

Section 13
21S 24W

Section 18
21S 23W

Top Perf: 4840'
-99.898432 38.221313

Miss Entry: 4827'
-99.898432 38.221313

Section 24
21S 24W

Section 19
21S 23W



Actual Bottom-Hole Location of Stairrett 1-18H
Hodgeman County, Kansas
T&R: 21S 23W
Section: 14, 329' FWL & 405' FNL
Long/Lat: -99.898559 38.232205
1 in = 833 ft




● Actual BH Location

* SandRidge Wells

--- Perf

□ Sections

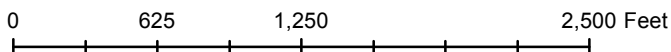

Draftsman:

Aaron Birk

Draft Date: 8/7/2012

Drawing Name/Number:

Addendum_Stairrett_1-18H.mxd

Coordinate System:

NAD 1927 State Plane
Kansas South FIPS: 1502