

Section 18  
26S 29W

Section 17  
26S 29W

BLEUMER 2629 1-19H



Miss Entry: 5067'  
-101 37.779186

Top Perf: 5530'  
-101 37.777888

Section 19  
26S 29W

Section 20  
26S 29W

Bottom Perf: 8983'  
-101 37.768678

BHL: 9351'  
-101 37.767615

108' FEL

516' FSL

Section 30  
26S 29W

Section 29  
26S 29W



**Actual Bottom-Hole Location of Bleumer 2629 1-19H**  
Gray County, Kansas  
T&R: 26S 29W  
Section: 4, 108' FEL & 516' FSL  
Long/Lat: -101 37.767615  
1 in = 667 ft




● Actual BH Location

\* SandRidge Wells

--- Perf

□ Sections

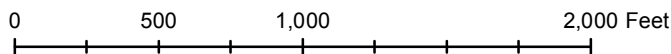

Draftsman:

Aaron Birk

Draft Date: 8/31/2012

Drawing Name/Number:

Addendum\_Bleumer\_2629\_1-19H H.mxd

Coordinate System:

NAD 1927 State Plane  
Kansas South FIPS: 1502