




**Unit Petroleum Company**

Date of Last Revision:  
**7-Aug-14**

**Well:** Overall 2-21H  
**Location:** 21-25S-10W  
**County, State:** Reno County, KS  
**Surface Location:** 190' FSL and 2310' FEL

**API No.:** 1515521690  
**Rig:** Unit Drilling #331  
**Engineer:** Brent Keys (918) 477-4510  
**Geology:** Rob Wilson (918) 477-5728

**OH Size**

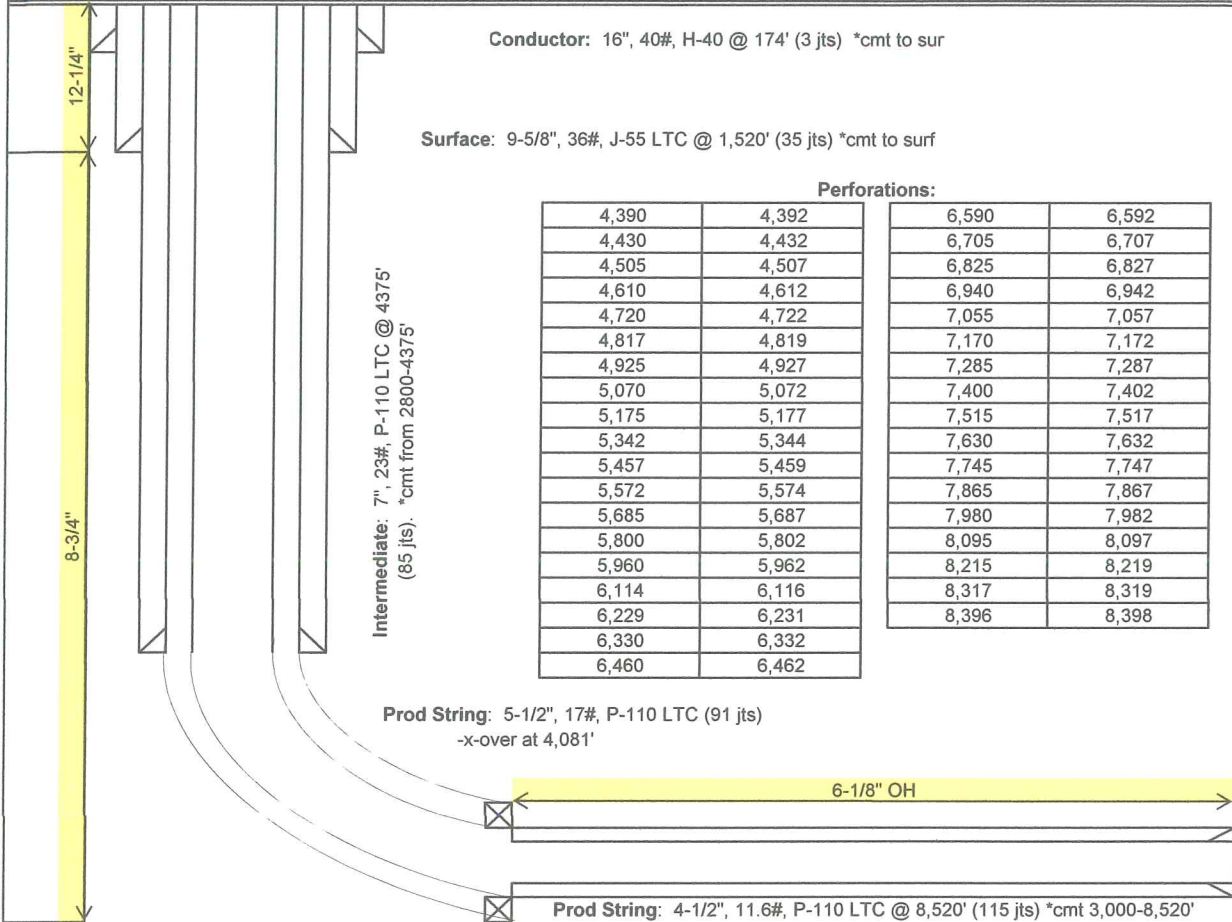

**Perforations:**

4,390	4,392	6,590	6,592
4,430	4,432	6,705	6,707
4,505	4,507	6,825	6,827
4,610	4,612	6,940	6,942
4,720	4,722	7,055	7,057
4,817	4,819	7,170	7,172
4,925	4,927	7,285	7,287
5,070	5,072	7,400	7,402
5,175	5,177	7,515	7,517
5,342	5,344	7,630	7,632
5,457	5,459	7,745	7,747
5,572	5,574	7,865	7,867
5,685	5,687	7,980	7,982
5,800	5,802	8,095	8,097
5,960	5,962	8,215	8,219
6,114	6,116	8,317	8,319
6,229	6,231	8,396	8,398
6,330	6,332		
6,460	6,462		