

Section 16
26S 29W

Section 15
26S 29W * MILLERSHASKI 2629 1-15H

TOEWS 2629 1-21H



Miss Entry: 4931'
-100 37.778989


Top Perf: 5243'
-100 37.778278

Section 21
26S 29W

Section 22
26S 29W

Bottom Perf: 8972'
-100 37.768186

BHL: 9366'
-100 37.767089

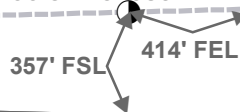

Section 28
26S 29W

Section 27
26S 29W



Actual Bottom-Hole Location of Toews 2629 1-21H
Gray County, Kansas
T&R: 26S 29W
Section: 21, 414' FEL & 357' FSL
Long/Lat: -100 37.767089
1 in = 667 ft




● Actual BH Location

* SandRidge Wells

--- Perf

□ Sections

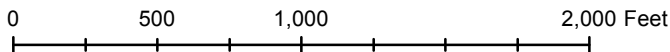

Draftsman:

Aaron Birk

Draft Date: 9/29/2012

Drawing Name/Number:

Addendum_Toews_2629_1-21H.mxd

Coordinate System:

NAD 1927 State Plane
Kansas South FIPS: 1502