

Section 35  
27S 21W

Section 36  
27S 21W

BHL: 9645'  
-99.578526 37.644293

307' FNL

564 FEL

Bottom Perf: 8957'  
-99.578451 37.642418

Section 2  
28S 21W

Section 1  
28S 21W

Top Perf: 5284'  
-99.577628 37.632463

Miss Entry: 4965'  
-99.577588 37.631718

BONES 2821 1-11H

Section 11  
28S 21W

Section 12  
28S 21W



**Actual Bottom-Hole Location of Bones 2821 1-11H**  
Ford County, Kansas  
T&R: 28S 21W  
Section: 2, 307' FNL & 564' FEL  
Long Lat: -99.578526 37.644293  
1 in = 650 ft




● Actual BH Location

\* SandRidge Wells

--- Perf

□ Sections

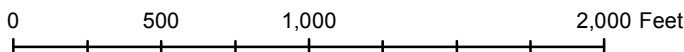

Draftsman:

Aaron Birk

Draft Date: 9/29/2012

Drawing Name/Number:

Addendum\_Bones\_2821\_1-11H.mxd

Coordinate System:

NAD 1927 State Plane  
Kansas South FIPS: 1502