

Section 4
18S 25W

Section 3
18S 25W

BHL: 8867'
-100 38.507326

413' FNL

496' FEL

Section 9
18S 25W

Section 10
18S 25W


Miss Entry: 4792'
-100 38.496292

Section 16
18S 25W

Section 15
18S 25W



Actual Bottom-Hole Location of Sutton 1-9H
Comanche County, Kansas
T&R: 35S 18W
Section: 9, 413' FNL & 496' FEL
Long Lat: -100 38.507326
1 in = 667 ft

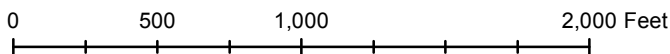

- Actual BH Location
- SandRidge Wells
- Perf
- Sections

Draftsman: Aaron Birk	Draft Date: 10/11/2012
Drawing Name/Number: Addendum_Sutton_1-9H .mxd	
Coordinate System: NAD 1927 State Plane Kansas South FIPS: 1502	