

Section 25  
22S 31W

Section 30  
22S 30W

BRANDT 2230 1-31H



Miss Entry: 4764'  
-101 38.102587


Top Perf: 5110'  
-101 38.101748

Section 36  
22S 31W

Section 31  
22S 30W

Bottom Perf: 8805'  
-101 38.091624

BHL: 9203'  
-101 38.090628

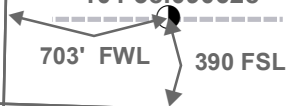

Section 1  
23S 31W

Section 6  
23S 30W



Actual Bottom-Hole Location of Brandt 22301-31H  
Finney County, Kansas  
T&R: 22S 30W  
Section: 31, 703 FWL & 390' FSL  
Long/Lat: -101 38.090628  
1 in = 833 ft




● Actual BH Location

\* SandRidge Wells

--- Perf

□ Sections

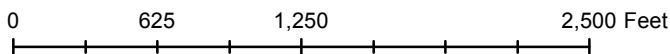

Draftsman:

Aaron Birk

Draft Date: 10/26/2012

Drawing Name/Number:

Addendum\_Brandt\_1-31H .mxd

Coordinate System:

NAD 1927 State Plane  
Kansas South FIPS: 1502