



Unit Petroleum Company


Date of Last Revision:

20-Oct-14

Well: Loudenback 18 #2H
Location: 07-25S-10W
County, State: Reno County, KS
Surface Location: 175' FSL & 600' FWL

API No.: 1515521691
Rig: Unit Drilling #331
Engineer: Tom Carrington (918) 477-4535
Geology: Rob Wilson (918) 477-5728

OH Size

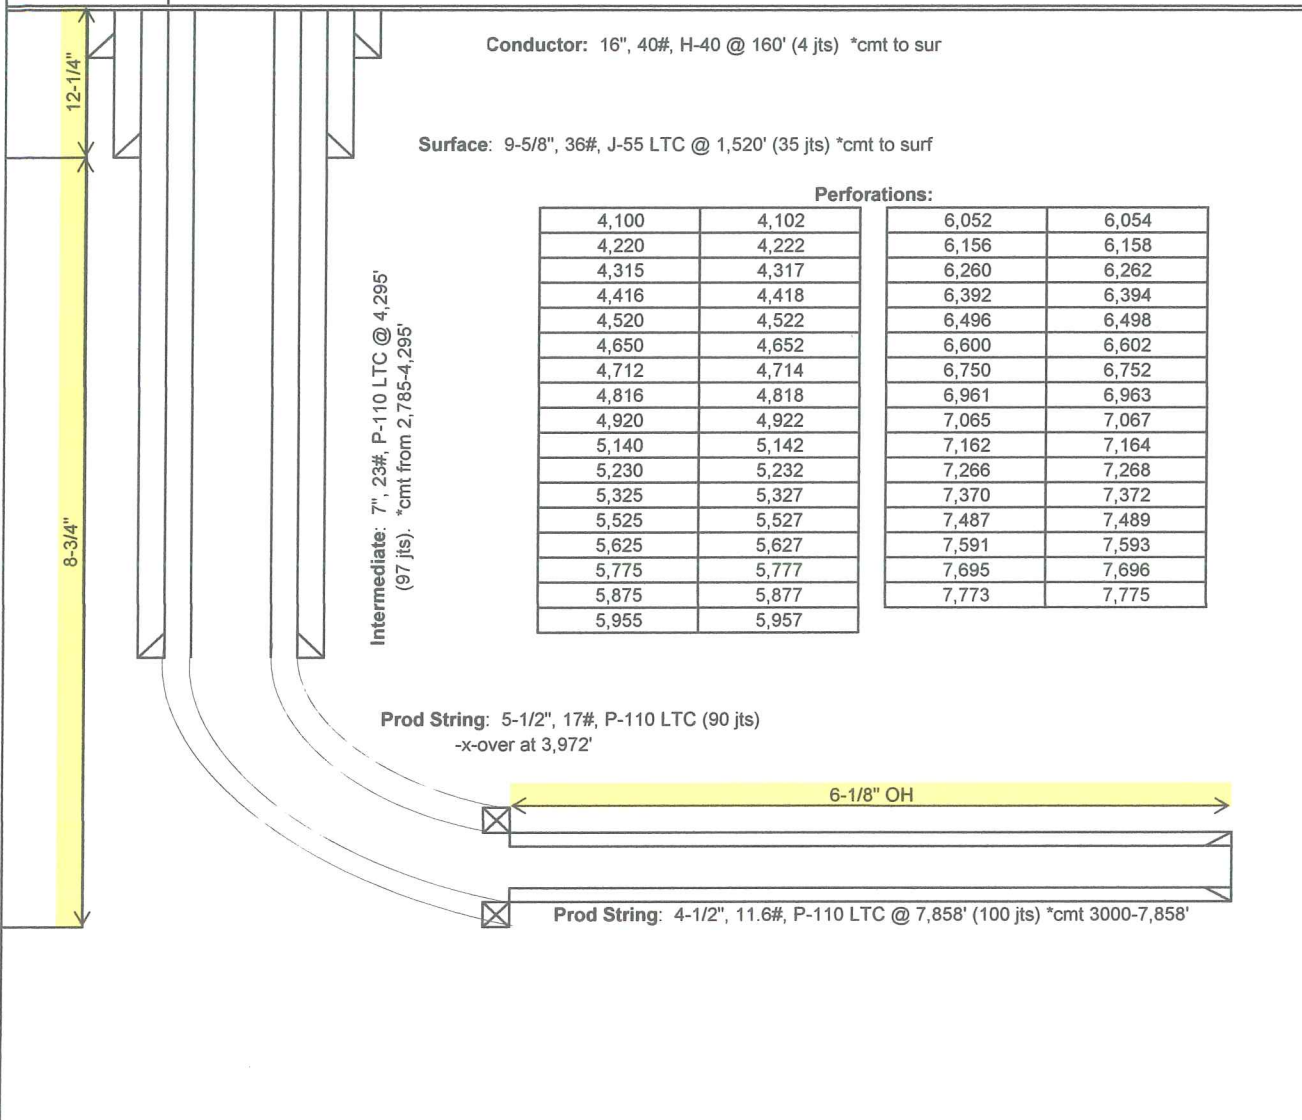

Perforations:

4,100	4,102	6,052	6,054
4,220	4,222	6,156	6,158
4,315	4,317	6,260	6,262
4,416	4,418	6,392	6,394
4,520	4,522	6,496	6,498
4,650	4,652	6,600	6,602
4,712	4,714	6,750	6,752
4,816	4,818	6,961	6,963
4,920	4,922	7,065	7,067
5,140	5,142	7,162	7,164
5,230	5,232	7,266	7,268
5,325	5,327	7,370	7,372
5,525	5,527	7,487	7,489
5,625	5,627	7,591	7,593
5,775	5,777	7,695	7,696
5,875	5,877	7,773	7,775
5,955	5,957		