

Section 27
34S 8W

Section 26
34S 8W

376' FNL

1933' FEL

BHL: 9485'

Bottom Perf: 8611'
-98.171866 37.048466

Section 35
34S 8W

Section 34
34S 8W

Top Perf: 4964'
-98.171459 37.038363

Miss Entry: 4952'
-98.171454 37.038287

MACY 2-34 SWD

MACY 1-34 SWD

JENNIFER 1-34H

JENNIFER 3408 3-34H

JENNIFER 3408 2-34H

JENNIFER 3408 4-34H

STARKS 1-35H

Section 3
35S 8W

Section 2
35S 8W



Actual Bottom-Hole Location of Jennifer 3408 2-34H
Harper County, Kansas
T&R: 34S 8W
Section: 34, 1933' FEL & 376' FNL
Long/Lat: -98.171834 37.04966
1 in = 667 ft




● Actual BH Location

* SandRidge Wells

--- Perf

□ Sections

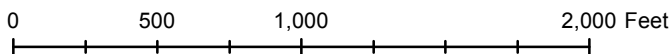

Draftsman:

Aaron Birk

Draft Date: 1/28/2013

Drawing Name/Number:

Addendum_Jennifer_2-34H .mxd

Coordinate System:

NAD 1927 State Plane
Kansas South FIPS: 1502