

Section 19  
30S 23W

JON 3023 1-19 SWD

Section 20  
30S 23W

ESPLUND FARMS 3023 1-30H

Miss Entry: 5596'  
-99.868686 37.409536


Top Perf: 5634'  
-99.868685 37.409378

Section 30  
30S 23W

Section 29  
30S 23W

Bottom Perf: -9240  
-99.868304 37.399555

BHL: 9700'  
-99.868317 37.398248

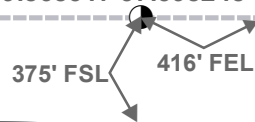

Section 31  
30S 23W

Section 32  
30S 23W



**Actual Bottom-Hole Location of Esplund Farms 3023 1-30H**  
Clark County, Kansas  
T&R: 30S 23W  
Section: 30, 416' FEL & 375' FSL  
Long/Lat: -99.868317 37.398248  
1 in = 667 ft




● Actual BH Location

\* SandRidge Wells

--- Perf

□ Sections

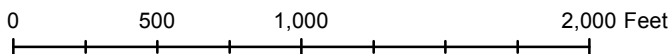

Draftsman:

Aaron Birk

Draft Date: 3/5/2013

Drawing Name/Number:

Addendum\_Esplund\_Farms\_1-30H.mxd

Coordinate System:

NAD 1927 State Plane  
Kansas South FIPS: 1502