

Section 17
26S 29W

* UNRUH 2629 2-17H

Section 16
26S 29W

TOEWS 2629 2-21H



Miss Entry: 5172'
-100.50482 37.778547


Top Perf: 5200'
-100.50481 37.778472

Section 20
26S 29W

Section 21
26S 29W

Bottom Perf: 8888'
-100.50477 37.768389

BHL: 9360'
-100.50475 37.767068

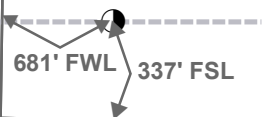

Section 29
26S 29W

Section 28
26S 29W



Actual Bottom-Hole Location of Toews 2629 2-21H
Gray County, Kansas
T&R: 26S 29W
Long/Lat: -100.50475 37.767068


1 in = 654 ft



● Actual BH Location

* SandRidge Wells

--- Perf
□ Sections

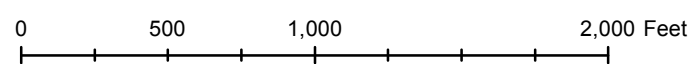

Draftsman: Aaron Birk	Draft Date: 3/25/2013
Drawing Name/Number: Addendum_Toews_2-21H.mxd	
Coordinate System: NAD 1927 State Plane Kansas South FIPS: 1502	