

Section 6
34S 6W

Section 5
34S 6W

604' FWL 332' FNL
●
BHL: 8867'
-98.000162 37.107993

Bottom Perf: 8418'
-98.00011 37.10684

Section 7
34S 6W

Section 8 Harper County
34S 6W

Top Perf: 5299'
-97.999863 37.097517

Miss Entry: 5027'
-97.999854 37.098297

TURNER 3406 6-7H TURNER 3406 5-7H TURNER 3406 2-7H TURNER 3406 1-7H MYRA 3406 1-8H MYRA 3406 2-8H DOROTHY 3406 1-8H

Section 18
34S 6W

Section 17
34S 6W



Actual Bottom-Hole Location of Myra 3406 1-8H
Harper County, Kansas
T&R: 34S 6W
Section: 8, 604' FWL & 332' FNL
-98.000162 37.107993

1 in = 703 ft




● Actual BH Location

* SandRidge Wells

--- Perf

□ Sections

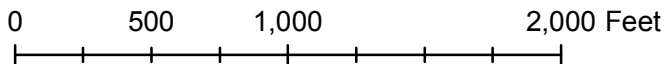

Draftsman:

Aaron Birk

Draft Date: 6/17/2013

Drawing Name/Number:

Addendum_Myra 3406 1-8H.mxd

Coordinate System:

NAD 1927 State Plane
Kansas South FIPS: 1502