

Section 32
33S 6W

Section 33
33S 6W

VALERIE 1-32



340' FNL 577' FEL

BHL: 8885'
-97.986237 37.122596

Bottom Perf: 8467'
-97.986322 37.121379

BILL 1-4



Section 5
34S 6W

Section 4
34S 6W

Top Perf: 5199'
-97.986472 37.112513

Miss Entry: 4904'
-97.986476 37.111648

BOLLMAN 3-4



MURRAY 3406 2-5H



MURRAY 3406 1-5H



Section 8
34S 6W

Section 9
34S 6W



Actual Bottom-Hole Location of Murray 3406 1-5H
Harper County, Kansas

T&R: 34S 6W
Section: 5, 577' FEL & 340' FNL
Long/Lat: -97.986237 37.122596

1 in = 833 ft




● Actual BH Location

* BaseMap.SANDRIDGE.Well

--- Perf

□ Sections

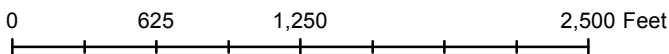

Draftsman:

Aaron Birk

Draft Date: 7/22/2013

Drawing Name/Number:

Addendum_Murray 3406 1-5H .mxd

Coordinate System:

NAD 1927 State Plane
Kansas South FIPS: 1502