

Section 7  
34S 6W

Section 8  
34S 6W

TURNER 3406 1-7H TURNER 3406 2-7H



Miss Entry: 4872'  
-98.004782 37.093093

Top Perf: 5333'  
-98.004783 37.093007

Section 18  
34S 6W

Section 17  
34S 6W

Bottom Perf: 9130'  
-98.004359 37.083042

BHL: 9487'  
-98.004338 37.081539

585' FSL

692' FEL

Section 19  
34S 6W

Section 20  
34S 6W



Actual Bottom-Hole Location of Turner 3406 6-7H  
Harper County, Kansas

T&R: 34S 6W  
Section: 18, 692' FEL & 585' FSL  
Long/Lat: -98.004591 37.115084

1 in = 833 ft




● Actual BH Location

\* SandRidge Wells

--- Perf

□ Sections

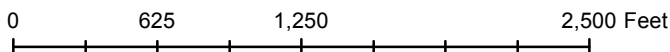

Draftsman:

Aaron Birk

Draft Date: 7/24/2013

Drawing Name/Number:

Addendum\_Turner 3406 6-7H.mxd

Coordinate System:

NAD 1927 State Plane  
Kansas South FIPS: 1502