

**Actual Bottom-Hole Location of Turner 3406 5-7H  
Harper County, Kansas**

**T&R: 34S 6W  
Section: 6, 665' FEL & 2263' FSL  
Long/Lat: -98.004591 37.115084**

**1 in = 833 ft**




● Actual BH Location

\* SandRidge Wells

--- Perf

□ Sections

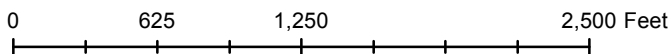

Draftsman:

Aaron Birk

Draft Date: 7/24/2013

Drawing Name/Number:

Addendum\_Turner 3406 5-7H.mxd

Coordinate System:

NAD 1927 State Plane  
Kansas South FIPS: 1502