


# Lampson 3B-23-32-9 H

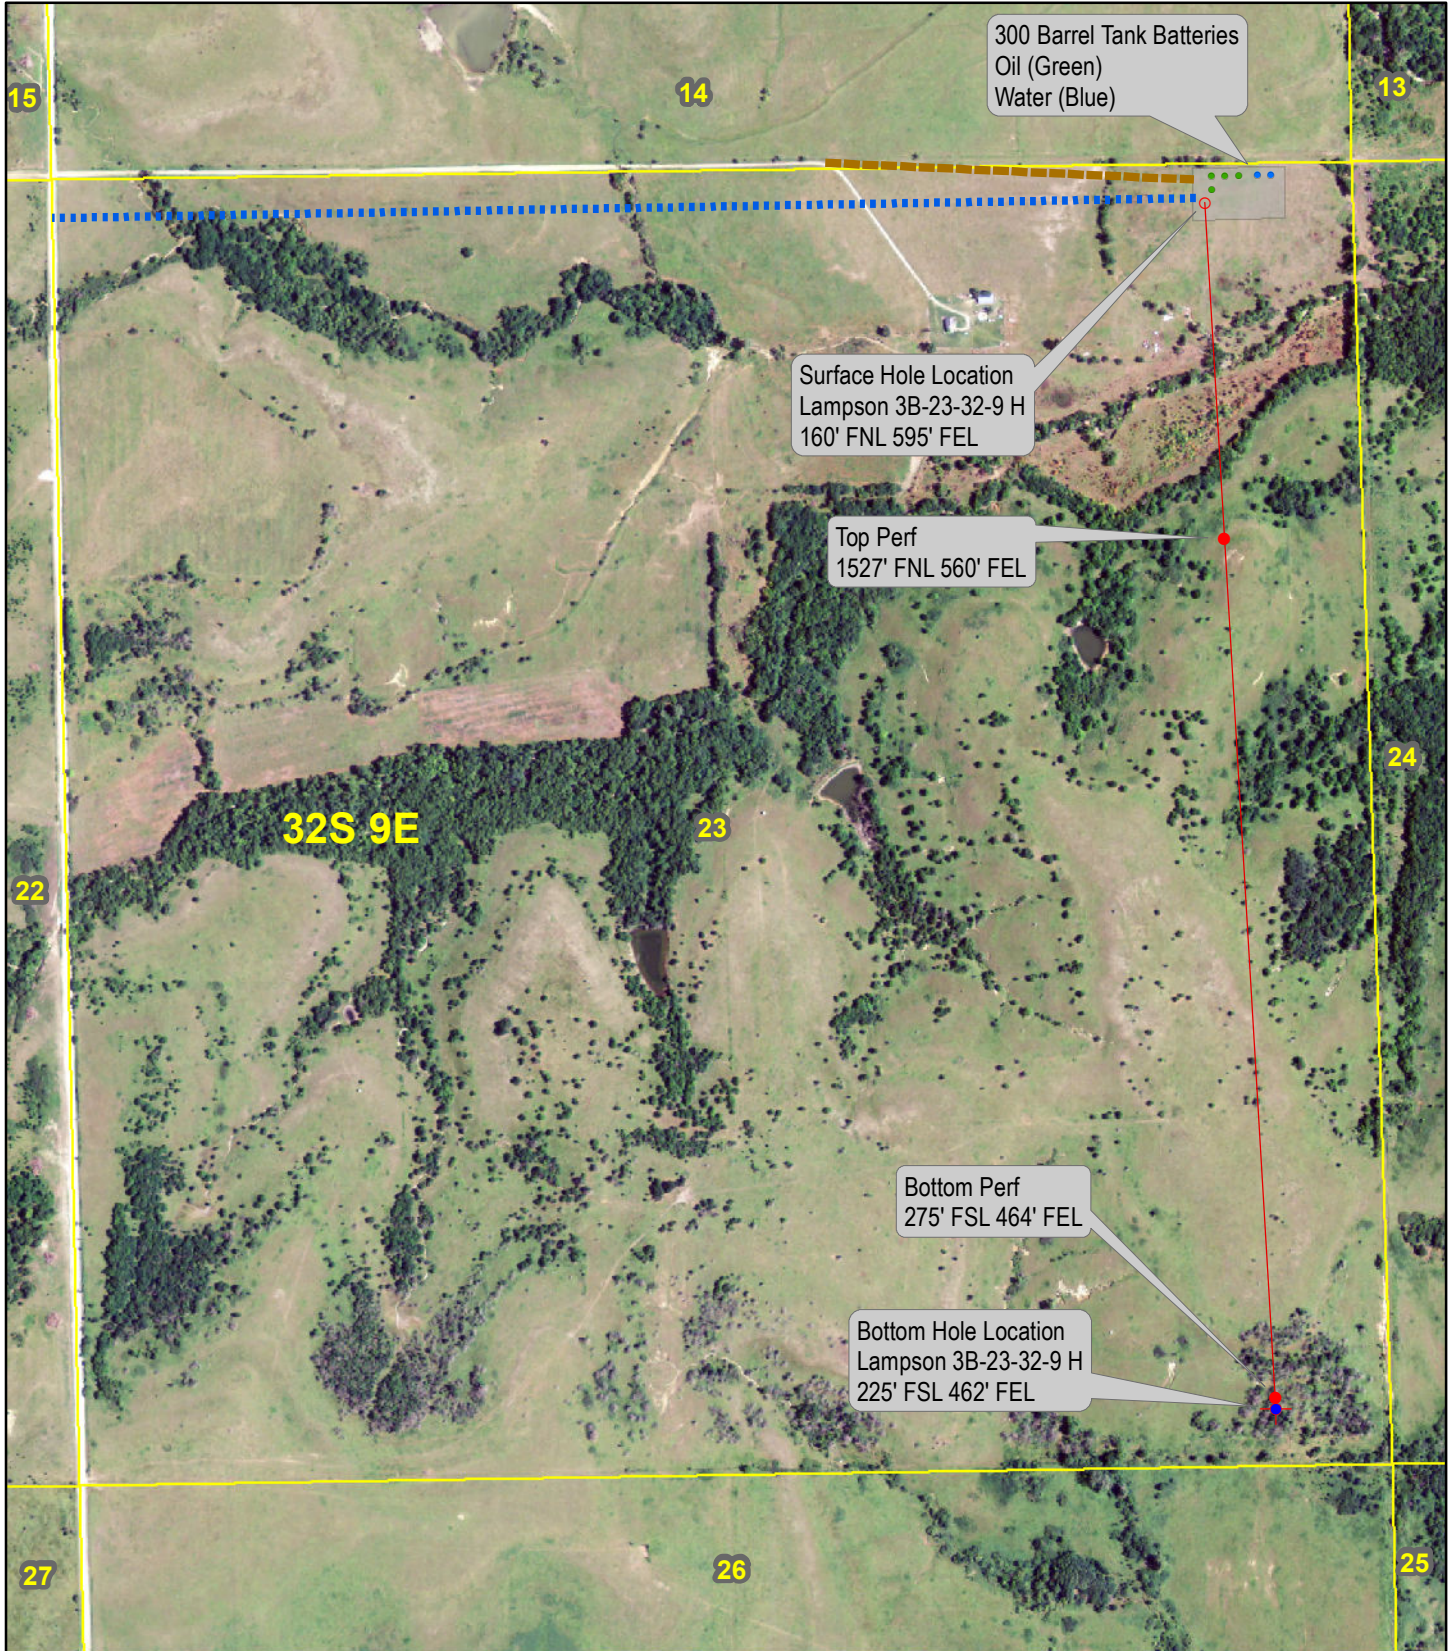

August 27, 2013



**N E M A H A**  
O I L A N D G A S

----- Lease Road  
 ..... Electric Line

