

Section 32  
33S 19W

Section 33  
33S 19W

THYME 3419 4-5H

THYME 3419 3-5H

THYME 3419 2-5H

THYME 3419 1-5H

Top Perf: 5432'  
-99.404465 37.11807

Miss Entry: 5497'  
-99.404452 37.11794

Bottom Perf: 9443'  
-99.404366 37.107043

BHL: 9684'  
-99.404356 37.106504

347' FSL

1930' FEL

Section 5  
34S 19W

Comanche County

Section 4  
34S 19W

Section 8  
34S 19W

Section 9  
34S 19W



Actual Bottom-Hole Location of Thyme 3419 2-5H  
Comanche County, Kansas  
T&R: 34S 19W  
Section: 5, 1930' FEL & 347' FNL  
-99.404356 37.106504

1 in = 631 ft




● Actual BH Location

\* SandRidge Wells

--- Perf

□ Sections

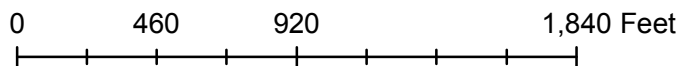

Draftsman:

Aaron Birk

Draft Date: 9/3/2013

Drawing Name/Number:

Addendum\_Thyme 3419 2-5H.mxd

Coordinate System:

NAD 1927 State Plane  
Kansas South FIPS: 1502